

WATER SERVICE RECORD

Name

Service No.

Address

8 Young Street

Location

Lot #166 - 169


~~Repair - General~~ - New Service~~Repair - General~~

Date	Material	Amount	Total	Date	Amount
7-29-61	Labor	5.73			
	10% O.H.	.57	6.30		
	7' 3/4" Copper tubing @.42		2.94		
	1 hr. Trucking @3.00		<u>3.00</u>		
	BILL WHEN CONNECTED		12.24	7-29-61	
					NON CHARGE
					Labor
					10' 3/4" Copper tubing @.42
					1 3/4" C Corp Cock
					1 3/4" C Curb Cock
					1 Box & Rod
					1 hr. Town Shovel @.6.50
					<u>6.50</u>
					34.97

TOWN OF LEXINGTON — BOARD OF PUBLIC WORKS

WATER DIVISION

Sketch of Service Here **8**

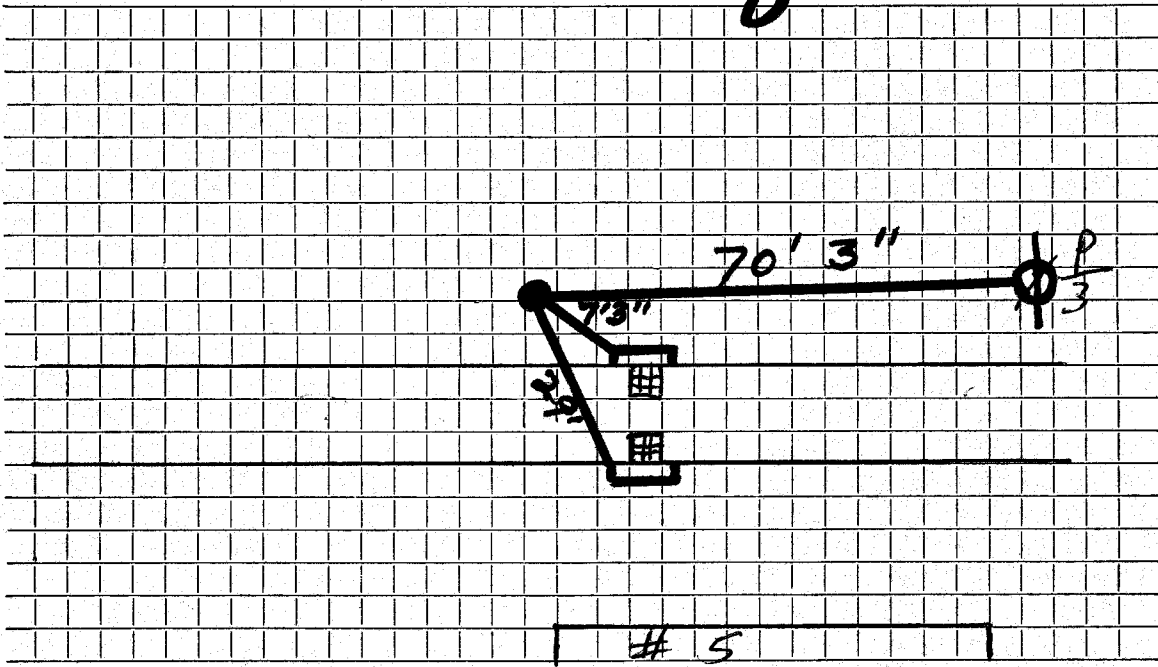

Connection made in Street. Work completed

Remarks:
.....
.....