
Date: 2/27/24

## TOWN OF LEXINGTON - BOARD OF PUBLIC WORKS SEWER DIVISION

SKETCH OF SERVICE HERE
4 Lillian Rd/2 Farm Rd

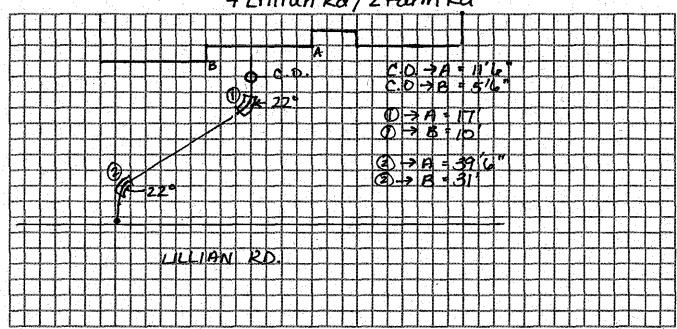

Connection made in:

Street,

Work completed:

Remarks: Installed by Sean S. Tocci Excavating

## Sewer Service Record

| Name                           | · .      | Service No.     |
|--------------------------------|----------|-----------------|
| Address 4 Lillian / 2 Farm Rd. |          |                 |
|                                | Location |                 |
| Kind of Pipe SDR 35 PVC        | Size 6   | Size of Main 8" |
| Repair Renewal New Service     |          | Location        |
|                                |          |                 |

| Date     | Material      | Amount   | Total     | Date     |   | Amount   |
|----------|---------------|----------|-----------|----------|---|----------|
| 2/27/24  | SDR 35 PVC 6" | ٠        |           |          |   |          |
|          |               |          |           | ,        | · |          |
| <u>.</u> | 6" Cleanout   |          |           |          |   |          |
|          |               |          |           |          |   | <u> </u> |
|          |               |          |           |          |   |          |
| ·        |               |          | [         |          |   |          |
|          | ·             |          |           |          |   |          |
|          |               |          | <br>      | <u> </u> |   |          |
| _        | <u> </u>      |          | <br>      |          |   |          |
|          |               |          |           |          |   |          |
|          |               |          | <u></u> _ |          |   |          |
|          | <u> </u>      |          |           |          |   |          |
|          |               | <u> </u> |           |          |   |          |
|          |               | ·        |           |          |   |          |
|          |               | <u></u>  |           |          |   |          |
| ·        |               |          |           |          |   |          |