


DATE 1 / 10 / 23

TOWN OF LEXINGTON — BOARD OF PUBLIC WORKS
SEWER DIVISION

Sketch of Service Here

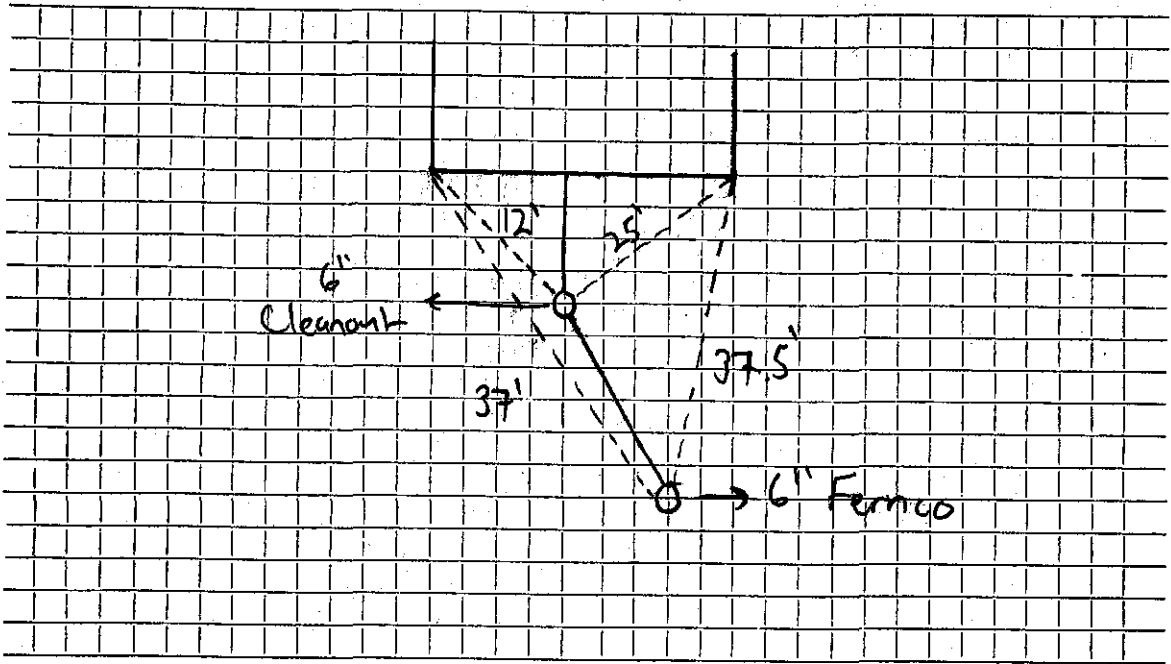

Connection made in Street. Work completed

Remarks: ..INSTALLED... By... SJ PEACOCK.....

