




Date: 2/29/24

TOWN OF LEXINGTON - BOARD OF PUBLIC WORKS  
WATER DIVISION

SKETCH OF SERVICE HERE  
4 Lillian Rd / 2 Farm Rd

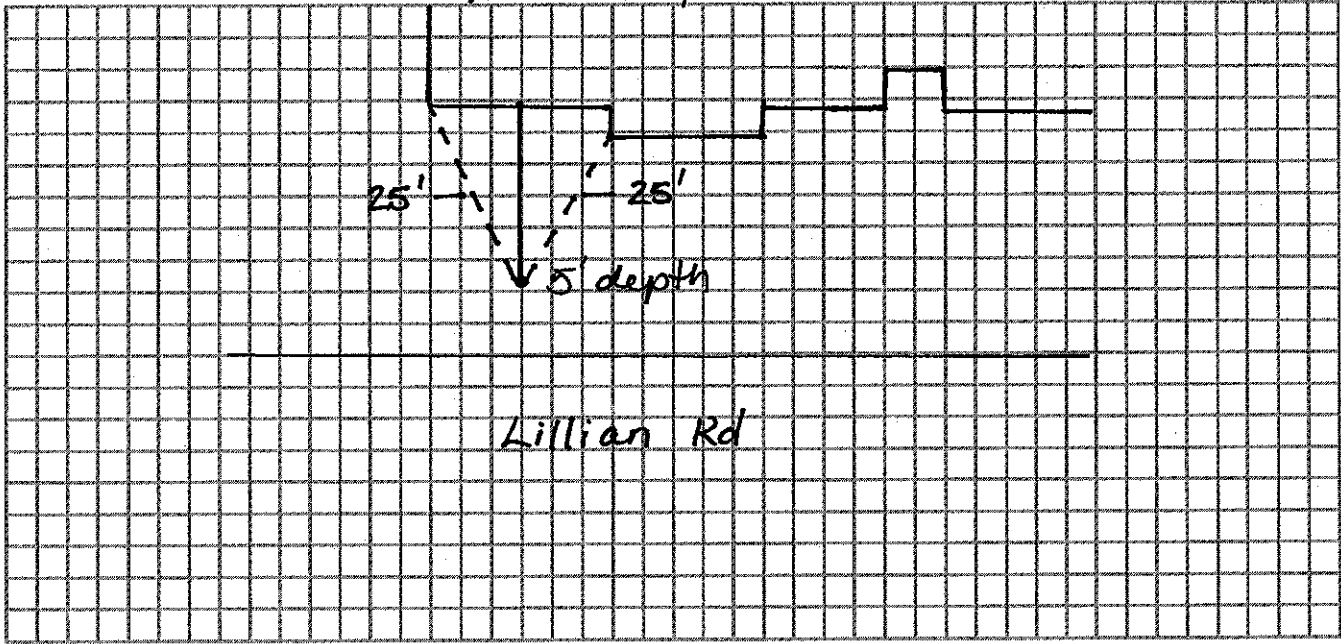

Connection made in: \_\_\_\_\_ Street. \_\_\_\_\_ Work completed: \_\_\_\_\_

Remarks: Installed by Tocci