


Date: 4/23/24

TOWN OF LEXINGTON - BOARD OF PUBLIC WORKS
WATER DIVISION

SKETCH OF SERVICE HERE
1 BEECH TREE LN

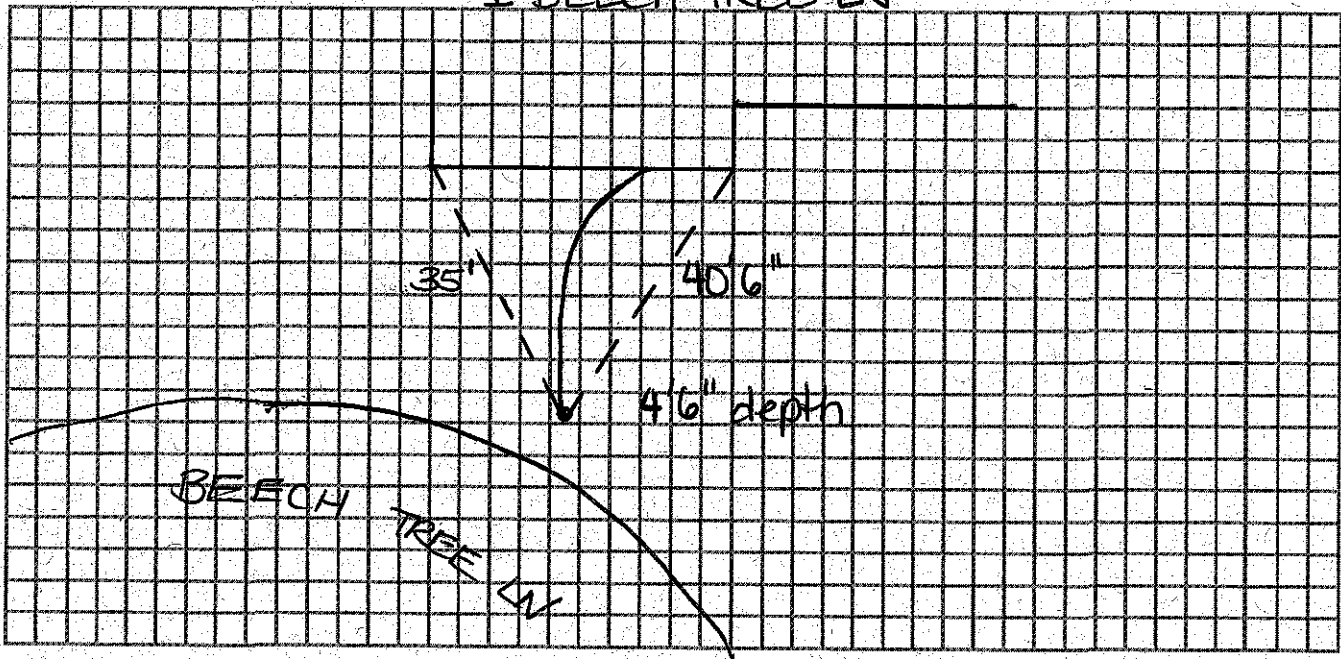

Connection made in: _____ Street. Work completed: _____

Remarks: McLaughlin

