


Date: 04/10/24

TOWN OF LEXINGTON - BOARD OF PUBLIC WORKS
WATER DIVISON

SKETCH OF SERVICE HERE
5 CART PATH LN

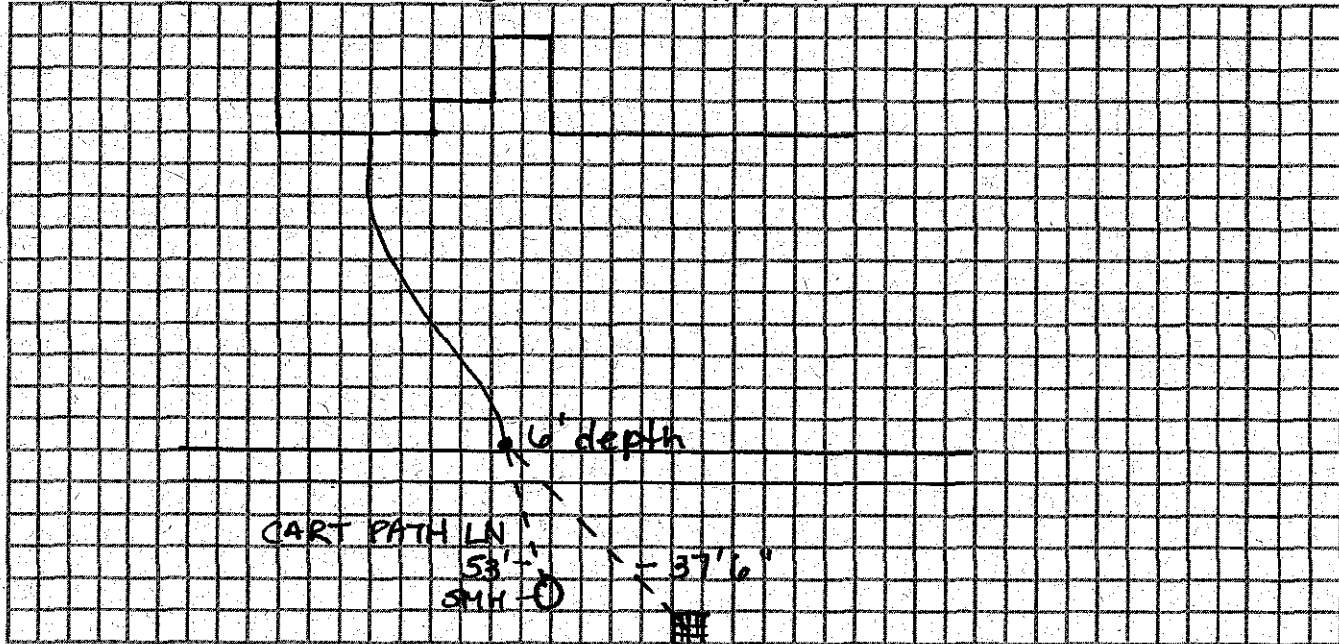

Connection made in:

Street.

Work completed:

Remarks: Sher - Corp

