


DATE 4/30/24

TOWN OF LEXINGTON — BOARD OF PUBLIC WORKS

WATER DIVISION
7 Cart Path Lane

Sketch of Service Here

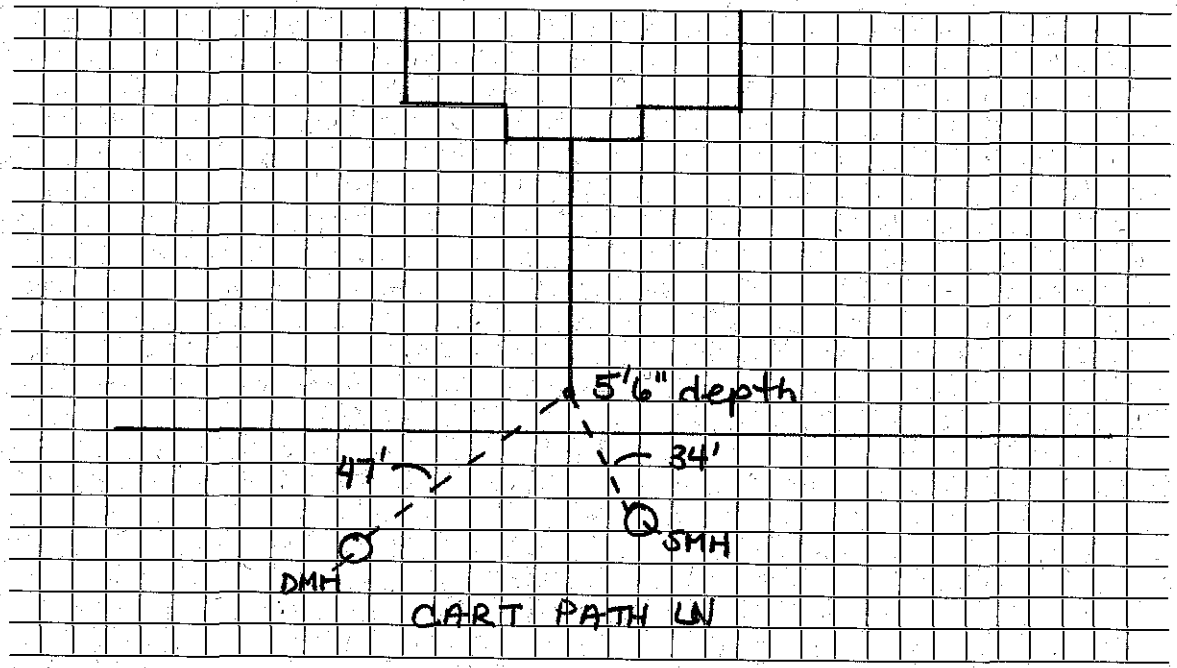

Connection made in Carl Path Ln Street. Work completed Sher-corp

Remarks:

.....

