


Date: 05/15/24

TOWN OF LEXINGTON - BOARD OF PUBLIC WORKS
WATER DIVISION

SKETCH OF SERVICE HERE
10 Fairland Commons

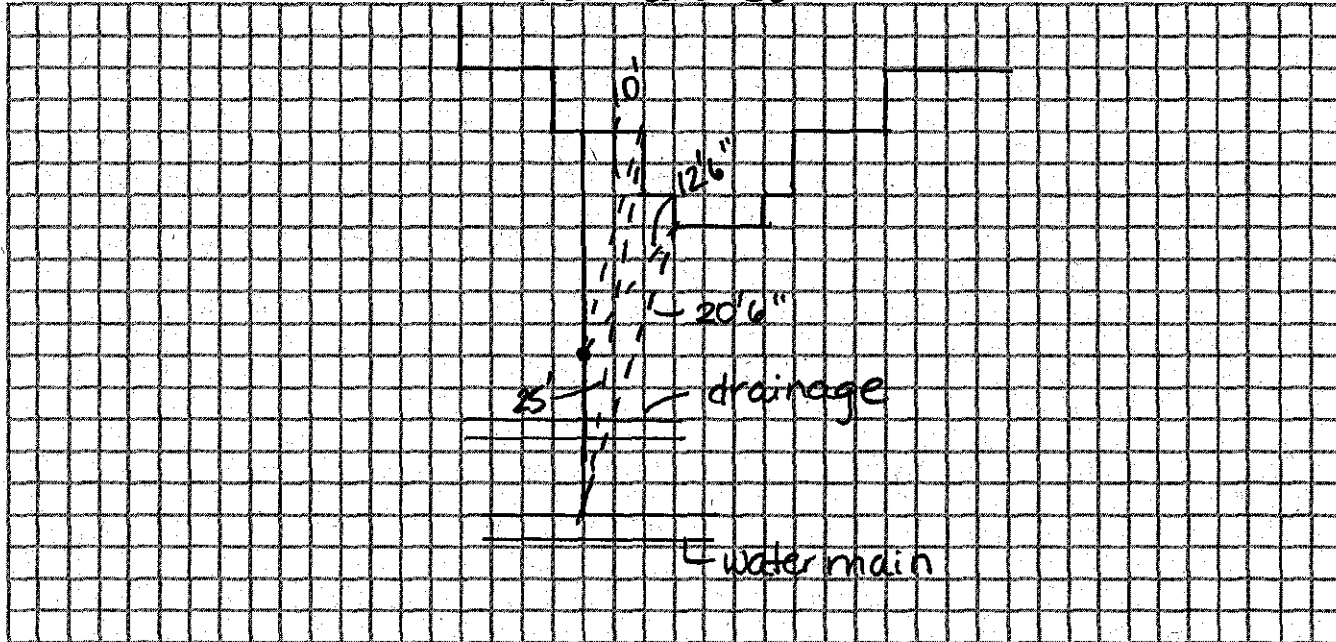

Connection made in: Fairland Commons Street.

Work completed: Baystate Engineering

Remarks:

