


Date: 05/15/24

TOWN OF LEXINGTON - BOARD OF PUBLIC WORKS  
WATER DIVISION

SKETCH OF SERVICE HERE  
12 Fairland Commons

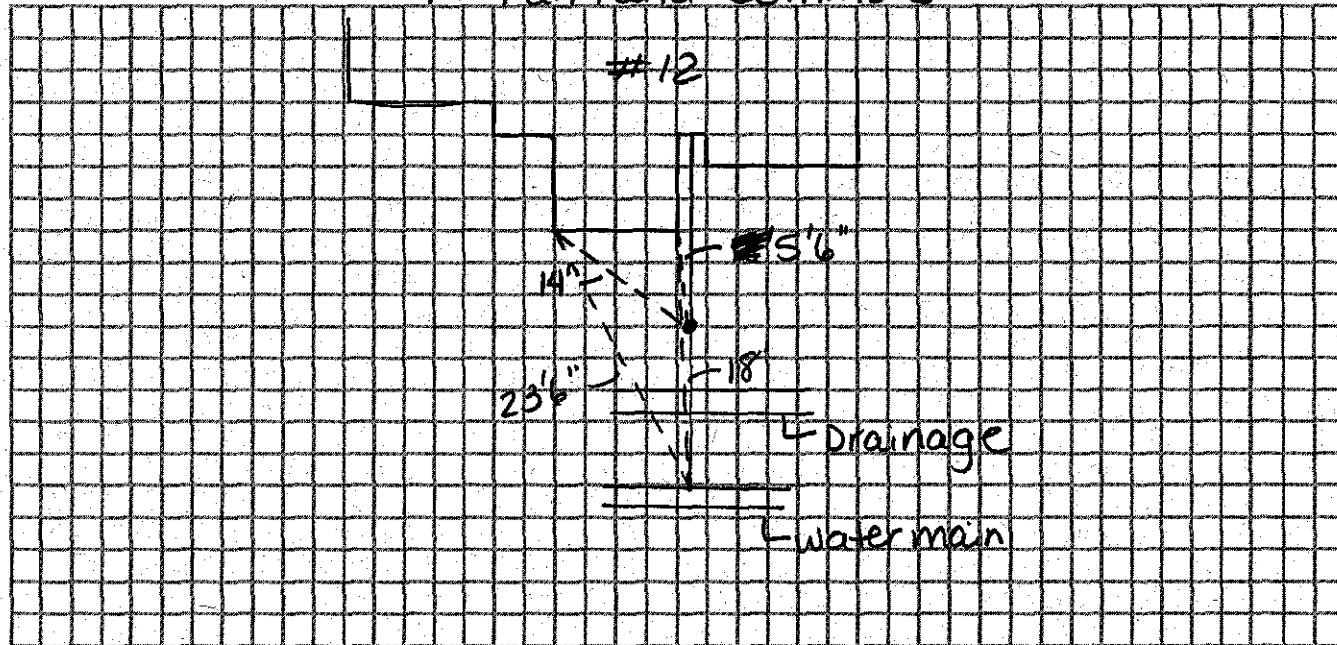

Connection made in: Fairland Commons Street.

Work completed: Baystate Engineering

Remarks:

