


DATE 05/09/24

TOWN OF LEXINGTON — BOARD OF PUBLIC WORKS

WATER DIVISION

Sketch of Service Here
18 Fairland Commons

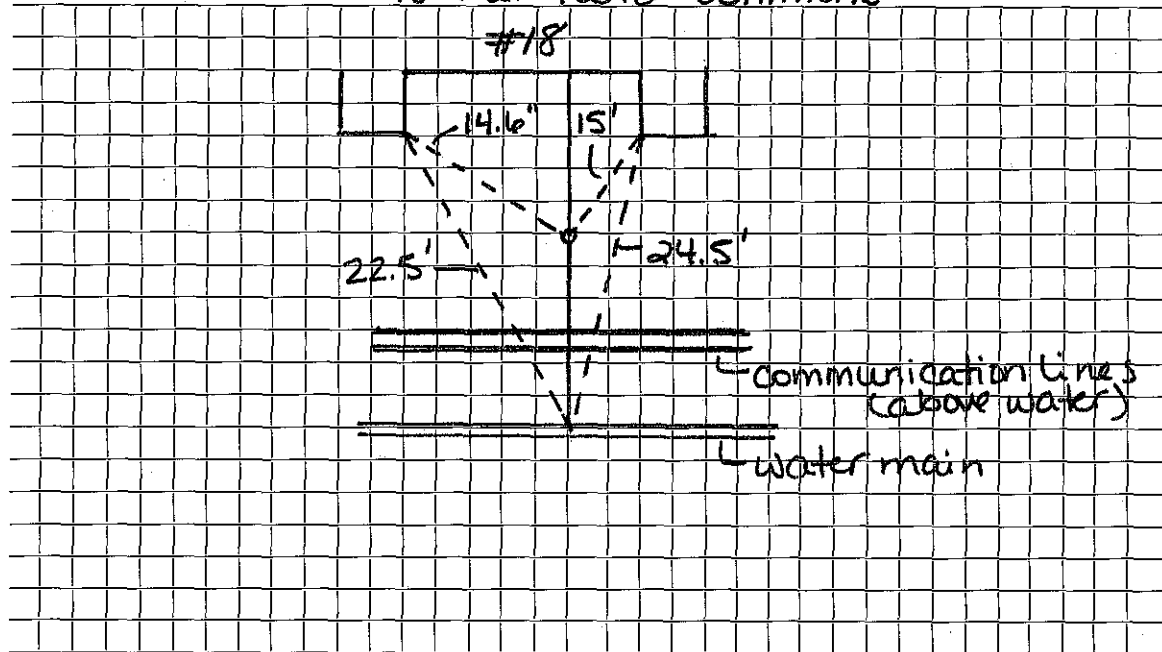

Connection made in Fairland Commons Street.

Work completed Baystate Engineering...

Remarks:

.....

.....