


DATE 05/09/24

TOWN OF LEXINGTON — BOARD OF PUBLIC WORKS

**WATER DIVISION**  
*22 Fairland Commons*

Sketch of Service Here

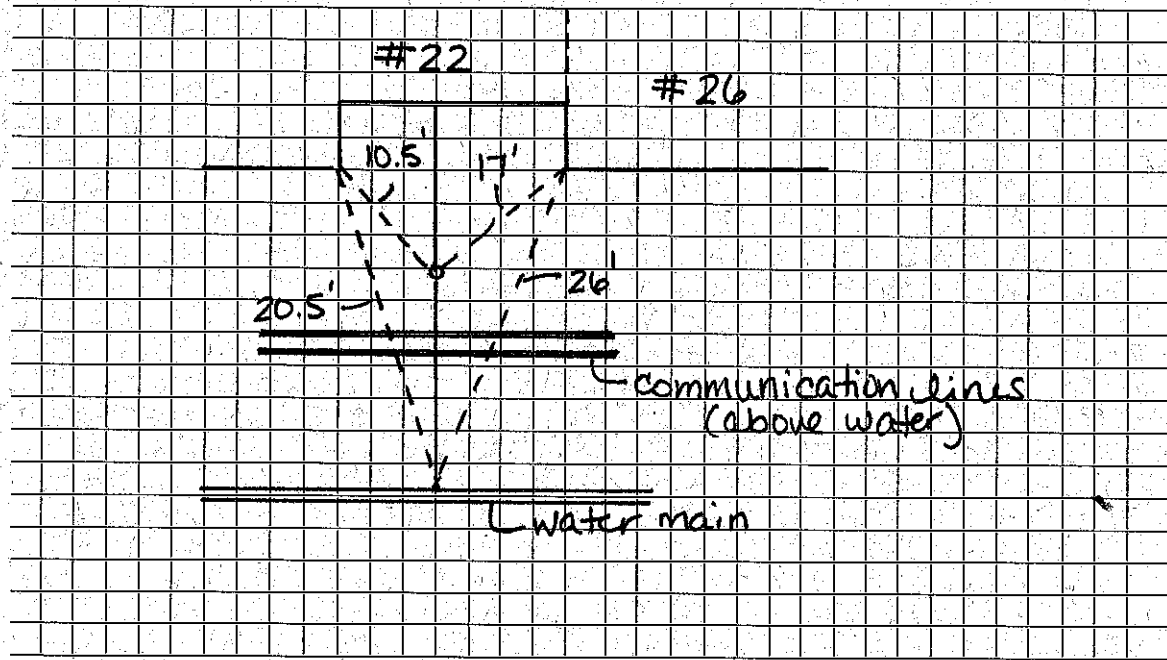

Connection made in Fairland Commons Street. Work completed Baystate Engineering

Remarks: .....

.....

WATER SERVICE RECORD

Name

Service No.

Address 22 Fairland Commons

Location

Repair—Renewal—New Service

Date	Material	Amount		Total		Date		Amount
05/09/24	1" K Copper							
	1" curb stop open-right							
	buffalo box							