


DATE 06/26/24

TOWN OF LEXINGTON — BOARD OF PUBLIC WORKS
SEWER DIVISION

Sketch of Service Here
15 BIRD HILL RD

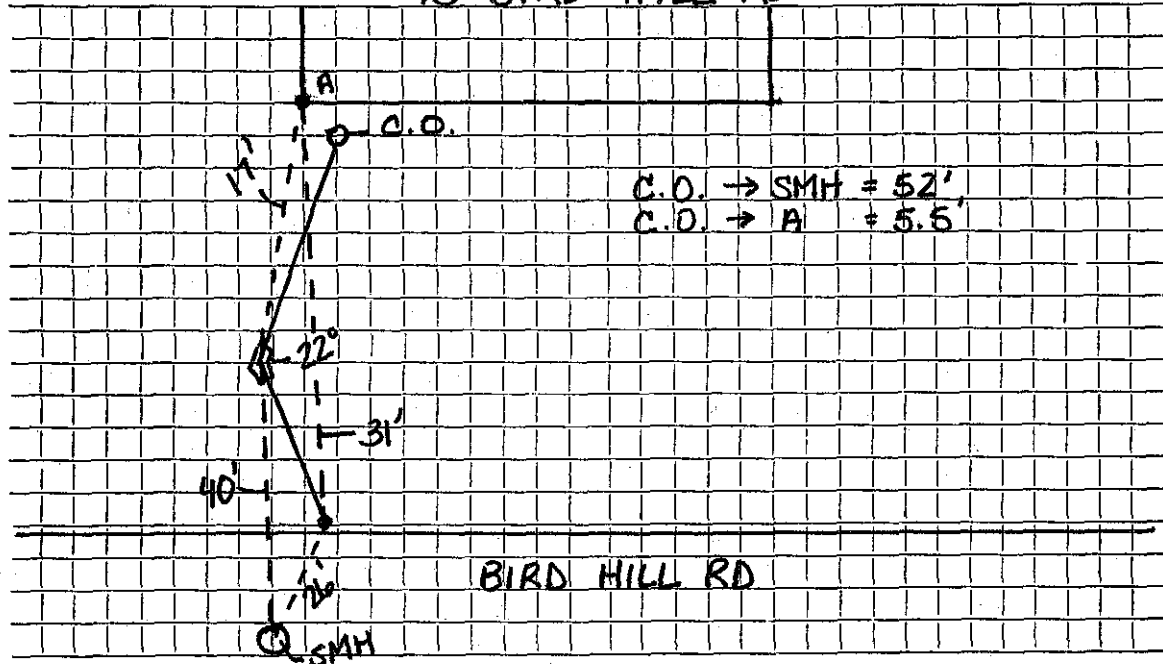

Connection made in Street. Work completed

Remarks: Installed by Geologic Excavation Inc.

