


DATE 3/22/24

TOWN OF LEXINGTON — BOARD OF PUBLIC WORKS
SEWER DIVISION

Sketch of Service Here
1 BEECH TREE LN

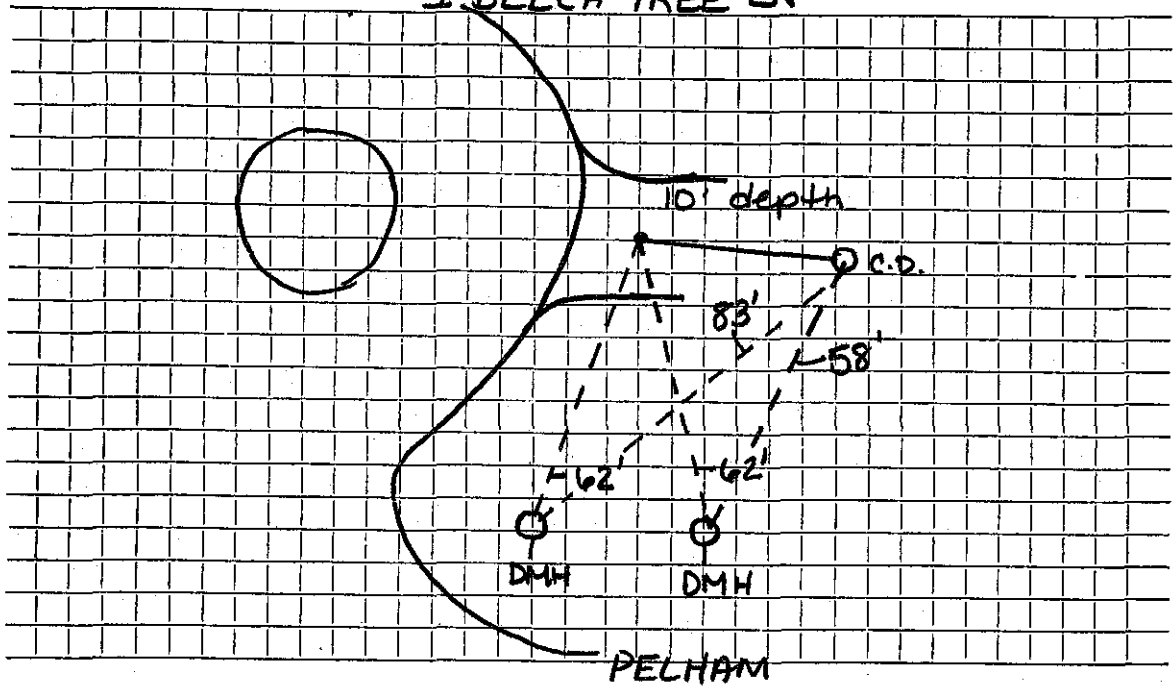

Connection made in Street. Work completed

Remarks: Installed by J.M. McLaughlin Inc.

