


DATE 02/20/24

TOWN OF LEXINGTON — BOARD OF PUBLIC WORKS
SEWER DIVISION

Sketch of Service Here
107 BLOSSOM CREST

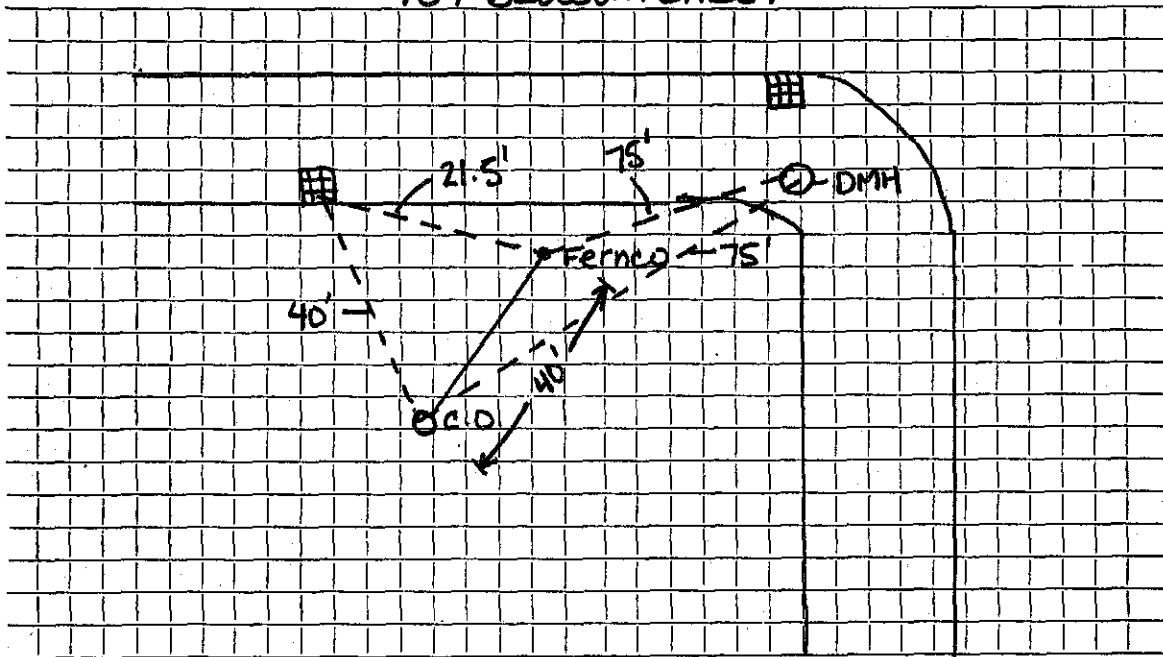

Connection made in Street. Work completed

Remarks: Installed by J.M. McLaughlin Inc.

