
Date: 4/09/24

TOWN OF LEXINGTON - BOARD OF PUBLIC WORKS SEWER DIVISION

SKETCH OF SERVICE HERE 5 CART PATH LANE

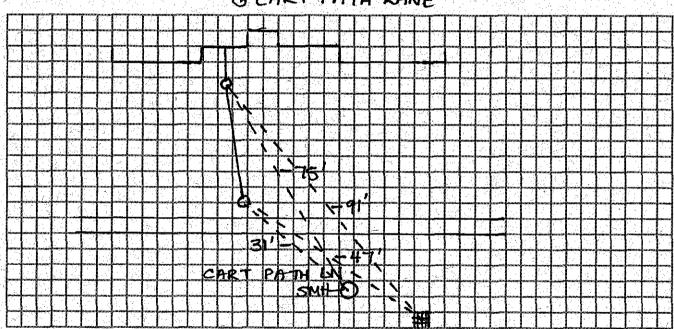

 1.5	2 (5		17/	1.6	
าท	oct	ion	m	201	e in:
 	CLL	1011	111	au	S 111.

Street.

Work completed:

Remarks: Installed by Sher-Corp

Sewer Service Record

Name 5 Cart Path Ln	Service No.		
Address			
	Location		
Kind of Pipe 6" SDR 35 PVC	Size 6	Size of Main 8	
Repair - Renewal New Service		Location	

Date	Material	Amount	Total	Date	Amount
4/09/24	6" SDR 35 PVC				
	6" clean out	2			
		*			
			-		
				-	
<u></u>					