


DATE 4/22/24

TOWN OF LEXINGTON — BOARD OF PUBLIC WORKS

SEWER DIVISION
2 Saddle Club Rd

Sketch of Service Here

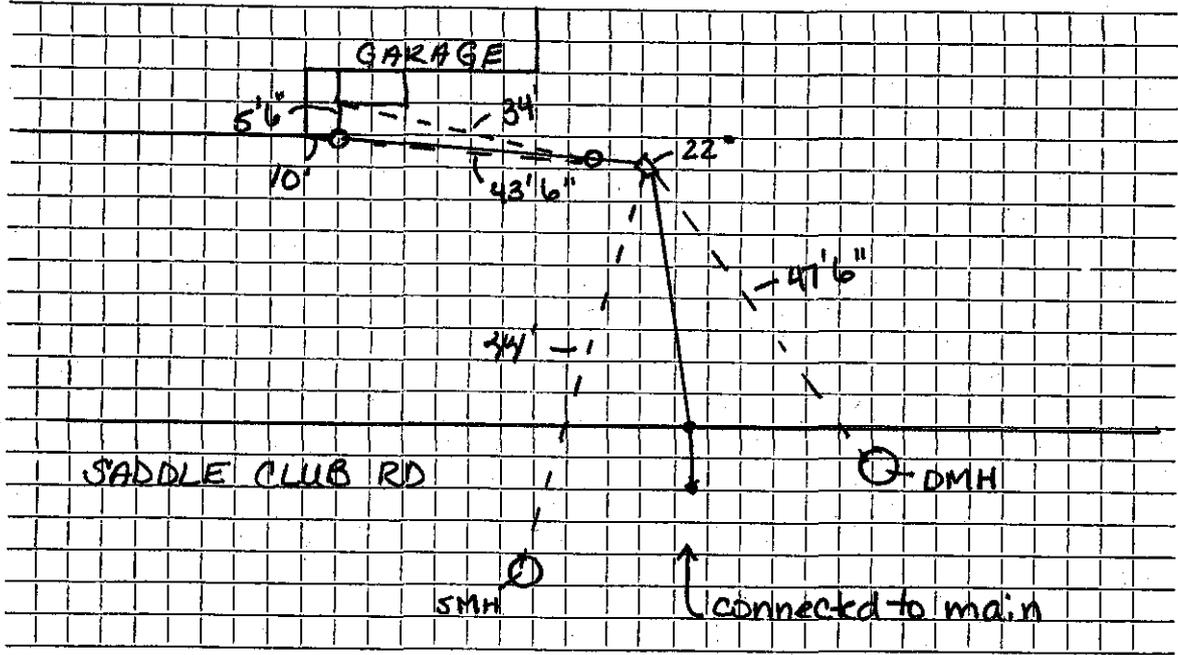

Connection made in SADDLE CLUB RD Street. Work completed Speedwagon

Remarks:

