



BEDFORD STREET

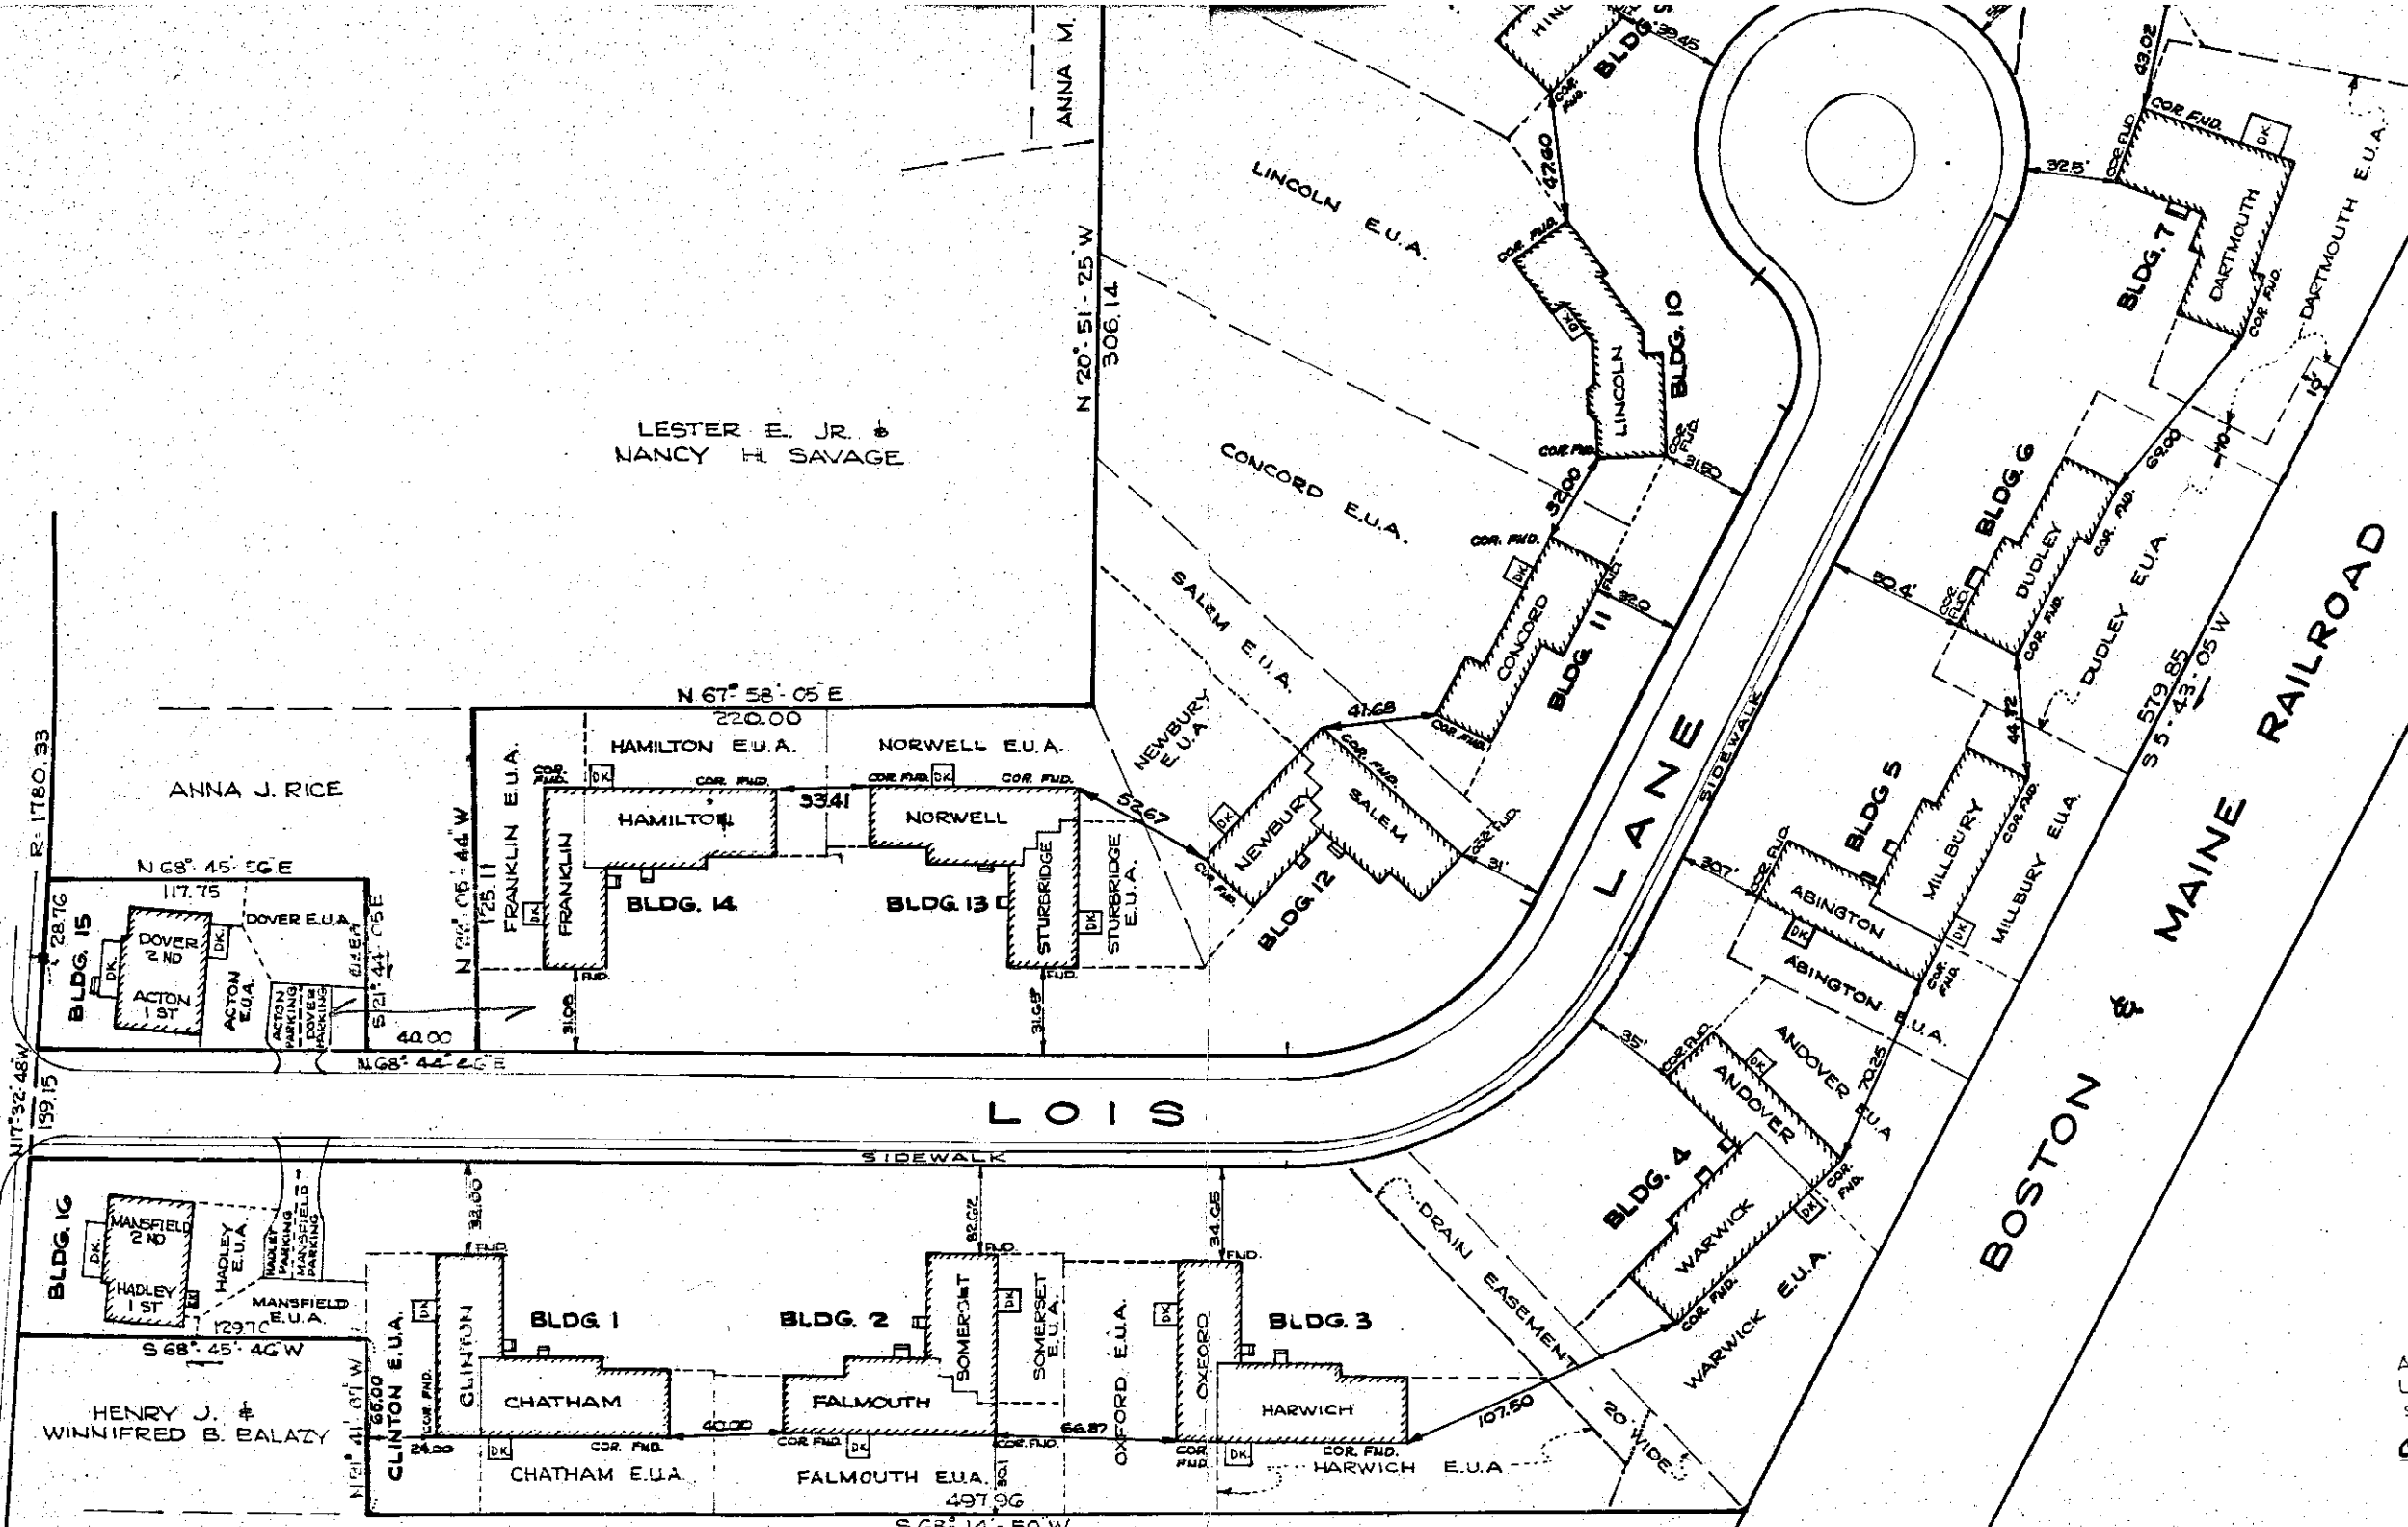

I HEREBY CERTIFY THAT
 AND ACCURATELY DEPICTS THE
 UNIT NUMBER, AND DIMENSIONS
 SIGNED UNDER THE PENALTY
 OF PERJURY.
 Oct. 17, 1975
 DATE REGISTERED

SITE
 CENTRE VILLAGE
 IN
 LEXINGTON
 SCALE 1" = 40'
 ALBERT A. MILLER
 CIVIL ENGINEER
 LEXINGTON
 SEPTEMBER

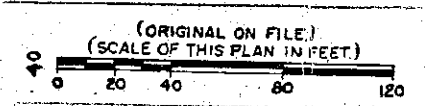

NOTE: E.U.A. DESIGNATES EXCLUSIVE USE AREA
 DK. DESIGNATES DECK

Plan Number 1160 of 1975
 Rec'd 10/4/75
 Middlesex Registry of Deeds, So. Dist.
 CAMBRIDGE, MASS.

2000
 R