


BEDFORD STREET

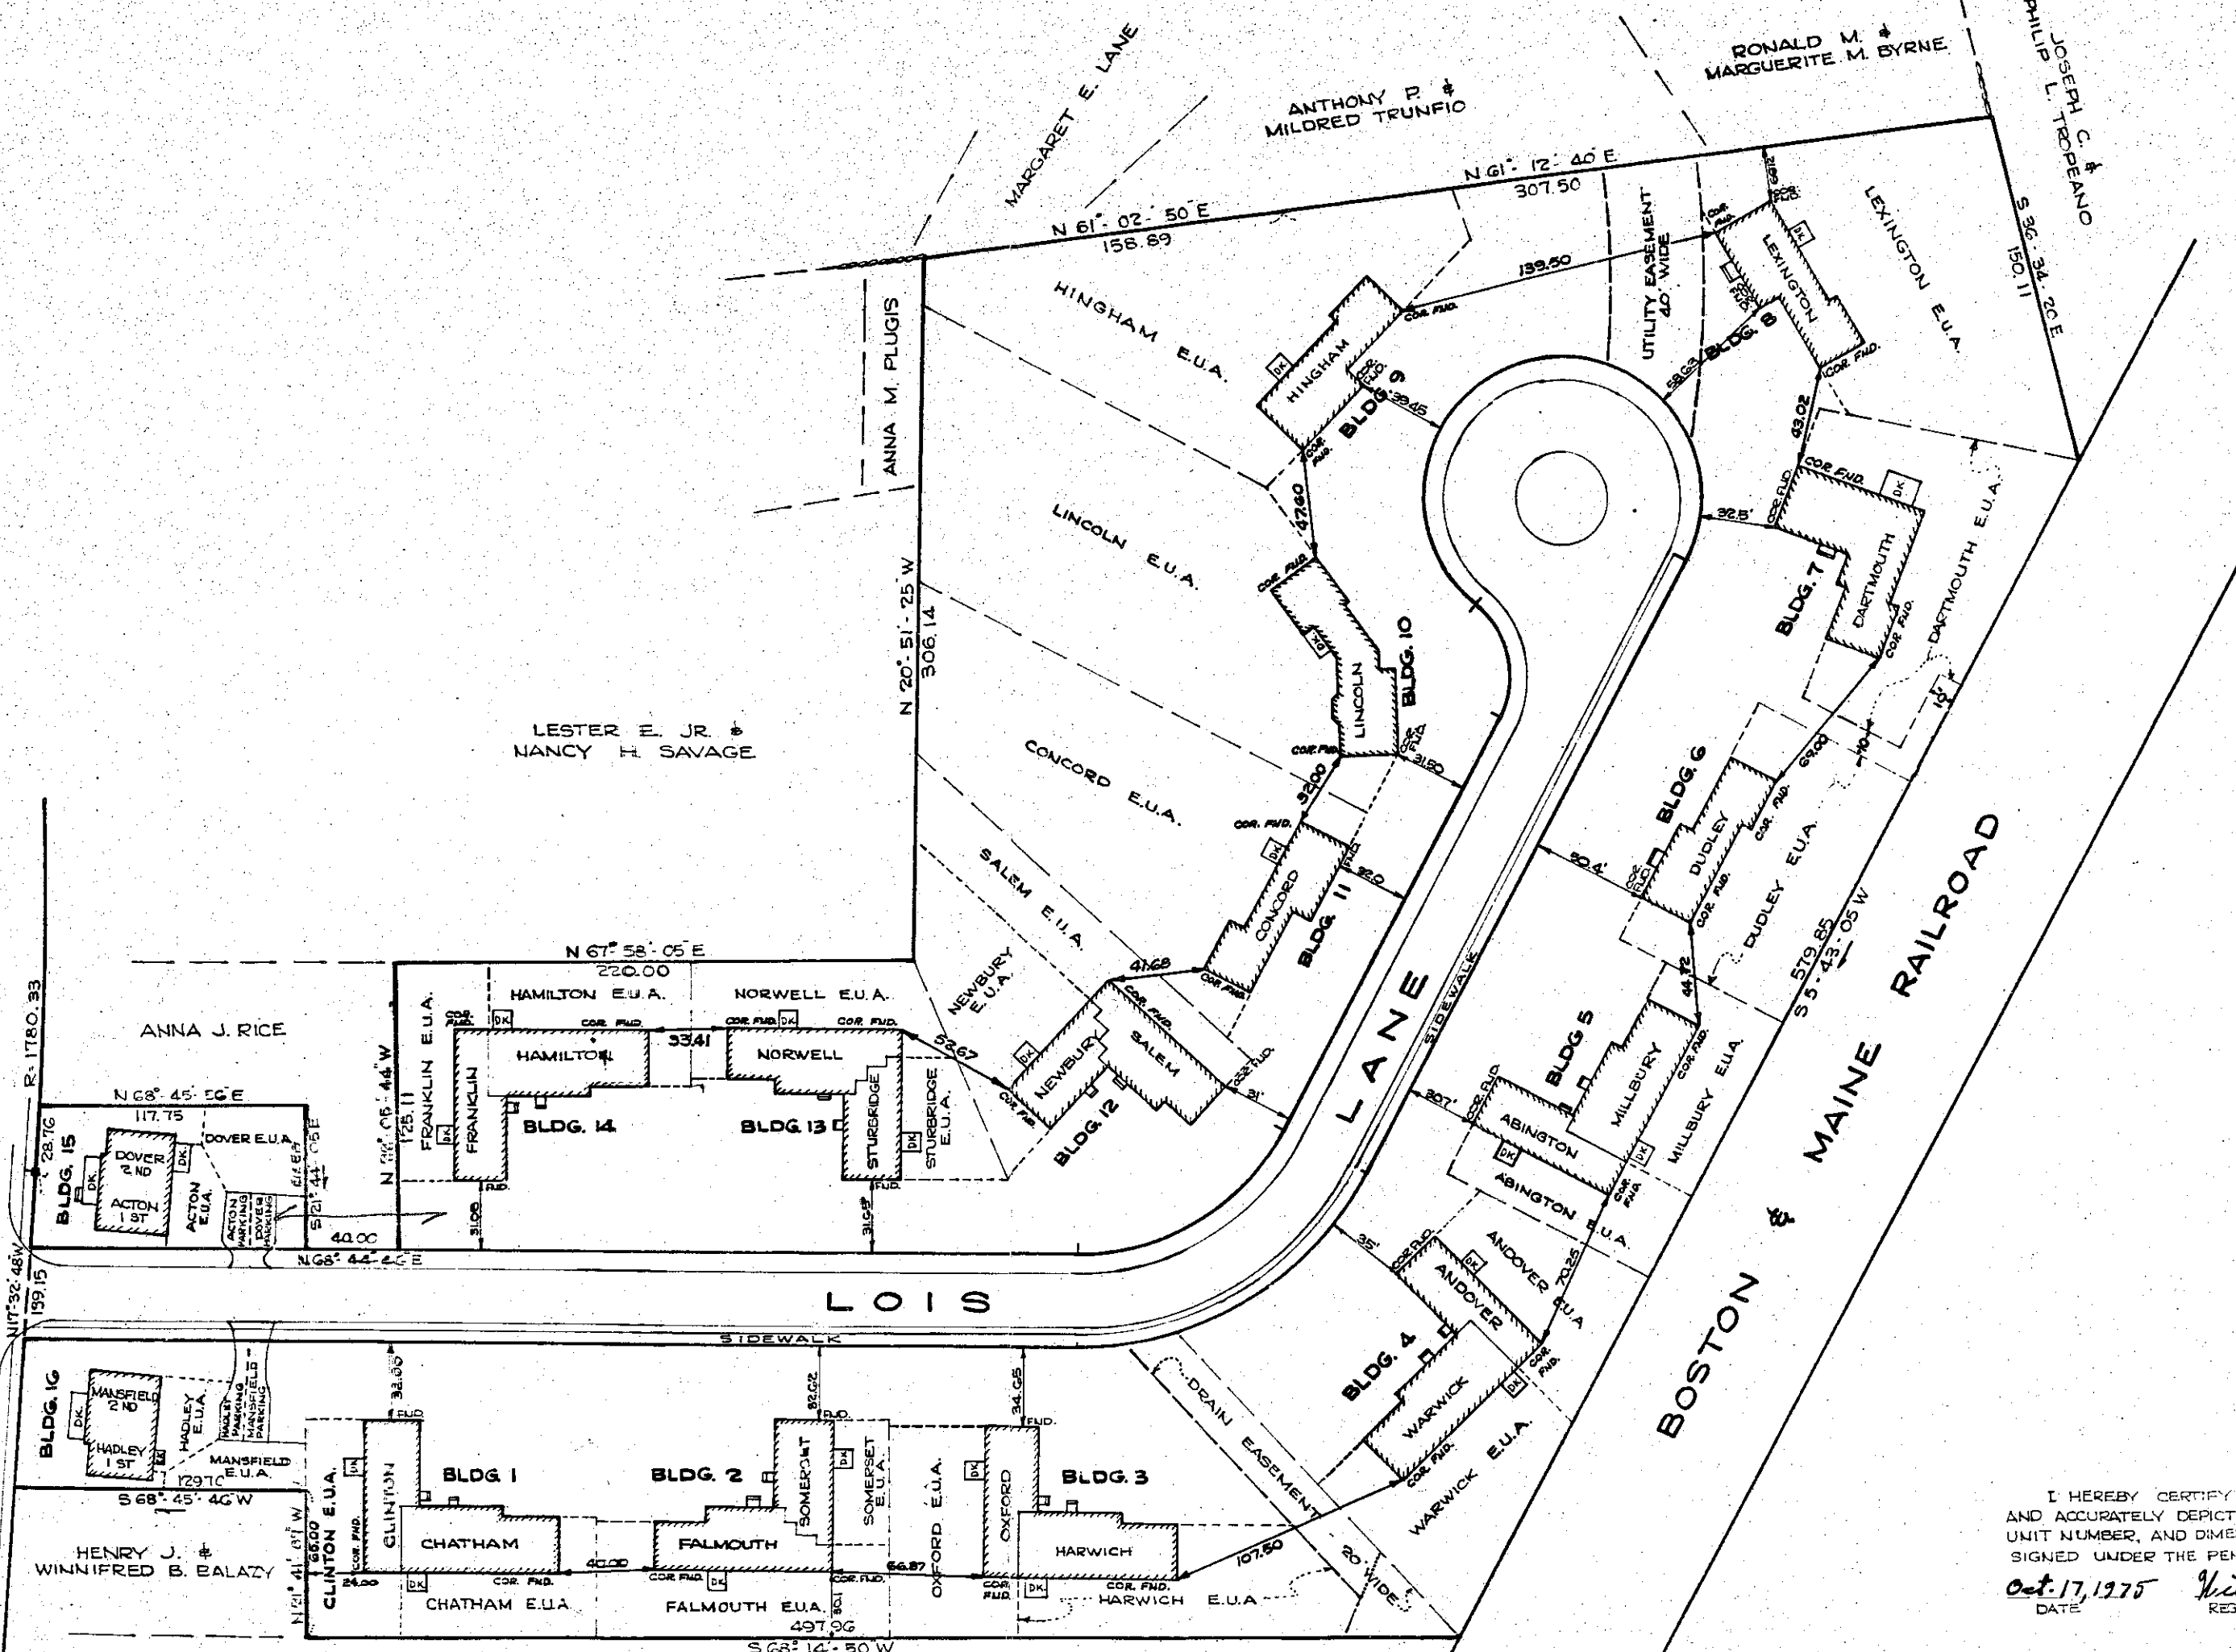

I HEREBY CERTIFY THAT
 AND ACCURATELY DEPICTS THE
 UNIT NUMBER, AND DIMENSION
 SIGNED UNDER THE PENALTY
 DATE *Oct. 17, 1975*
 REGISTER

Plan Number
 Rec'd
 CAMB

M. de la Cruz
 Registrar
 CAMB