


EXISTING CONDITIONS AND DEMOLITION PLAN
SCALE: 1"=10'

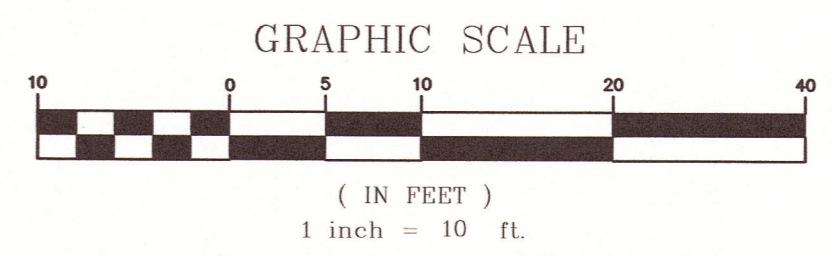

THESE RECORD DRAWINGS HAVE BEEN PREPARED, IN PART, ON THE BASIS OF THE INFORMATION COMPILED AND FURNISHED BY OTHERS. THE ENGINEER WILL NOT BE RESPONSIBLE FOR ANY ERRORS OR OMISSIONS WHICH HAVE BEEN INCORPORATED INTO THIS DOCUMENT AS A RESULT.

NO.	ISSUED FOR	DATE
1	ISSUED FOR BID	KMO 11/14
2	RECORD DRAWINGS	BAY 07/16

DESIGNED BY: AUK/BAY
 CADD: SCV
 CHECKED BY: KRO
 DATE: 11/14/14
 APPROVED BY: KMO
 DATE: 11/14/14
 PROJECT NO: 12938A

DESIGNED BY: AUK/BAY
 CADD: SCV
 CHECKED BY: KRO
 DATE: 11/14/14
 APPROVED BY: KMO
 DATE: 11/14/14
 PROJECT NO: 12938A

WRIGHT-PIERCE
 Engineering a Better Environment
 Offices Throughout New England
 888.621.8156 | www.wright-pierce.com

TOWN OF LEXINGTON, MA
 BRIGHAM ROAD WASTEWATER
 PUMP STATION UPGRADE

EXISTING CONDITIONS AND DEMOLITION PLAN

DRAWING
 C-2