


NORTH ELEVATION 1/4"=1'-0"

NOTE: RAILINGS OMITTED FOR CLARITY
SEE DRAWING #A-3
NOTE: "C" = 1 BRICK COURSE

WEST ELEVATION 1/4"=1'-0"

NOTE: RAILINGS OMITTED FOR CLARITY, SEE DRAWING #A-3

No.	1	5/95	RWS	MLM	FWY	RECORD DRAWING	Description
Date							
Dr. By							
Chk. By							
App. By							
REG. PROFESSIONAL ENGINEER	<p><i>Peter M. Smith</i> REGISTERED PROFESSIONAL ENGINEER</p>						
DATE	4/30/91						

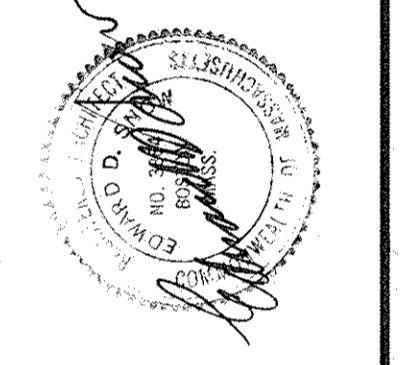

TOWN OF LEXINGTON, MASSACHUSETTS DEPARTMENT OF PUBLIC WORKS	DR. BY	CK. BY	APP. BY
NORTH LEXINGTON MAIN PUMPING STATION	EDS	EDS	EDS
BUILDING ELEVATIONS	SCALE	CONTRACT	FILE NO.
	1/4"=1'-0"	92-1	69-54
	CADD NO.	JOB NO.	DATE
		9065	5/2/91



RECORD DRAWING