


| | |
|----------------------------------|---------|
| RECORD DRAWING | DATE |
| DESCRIPTION | 4/30/91 |
| APPROVED | |
| DESIGNED | |
| DRAWN | |
| CHECKED | |
| DATE | |
| REGISTERED PROFESSIONAL ENGINEER | |

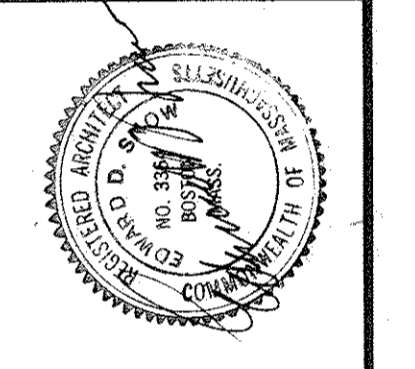

TOWN OF LEXINGTON, MASSACHUSETTS
DEPARTMENT OF PUBLIC WORKS
NORTH LEXINGTON MAIN PUMPING STATION

HORIZONTAL WALL SECTIONS

SCALE: 1/2" = 1'-0"
CONTRACT: 521
JOB NO.: 9065
DR. BY: FL
CK. BY: EDS
APP. BY: EDS

CADD NO.:
FILE NO.: 69-50

RECORD DRAWING

