
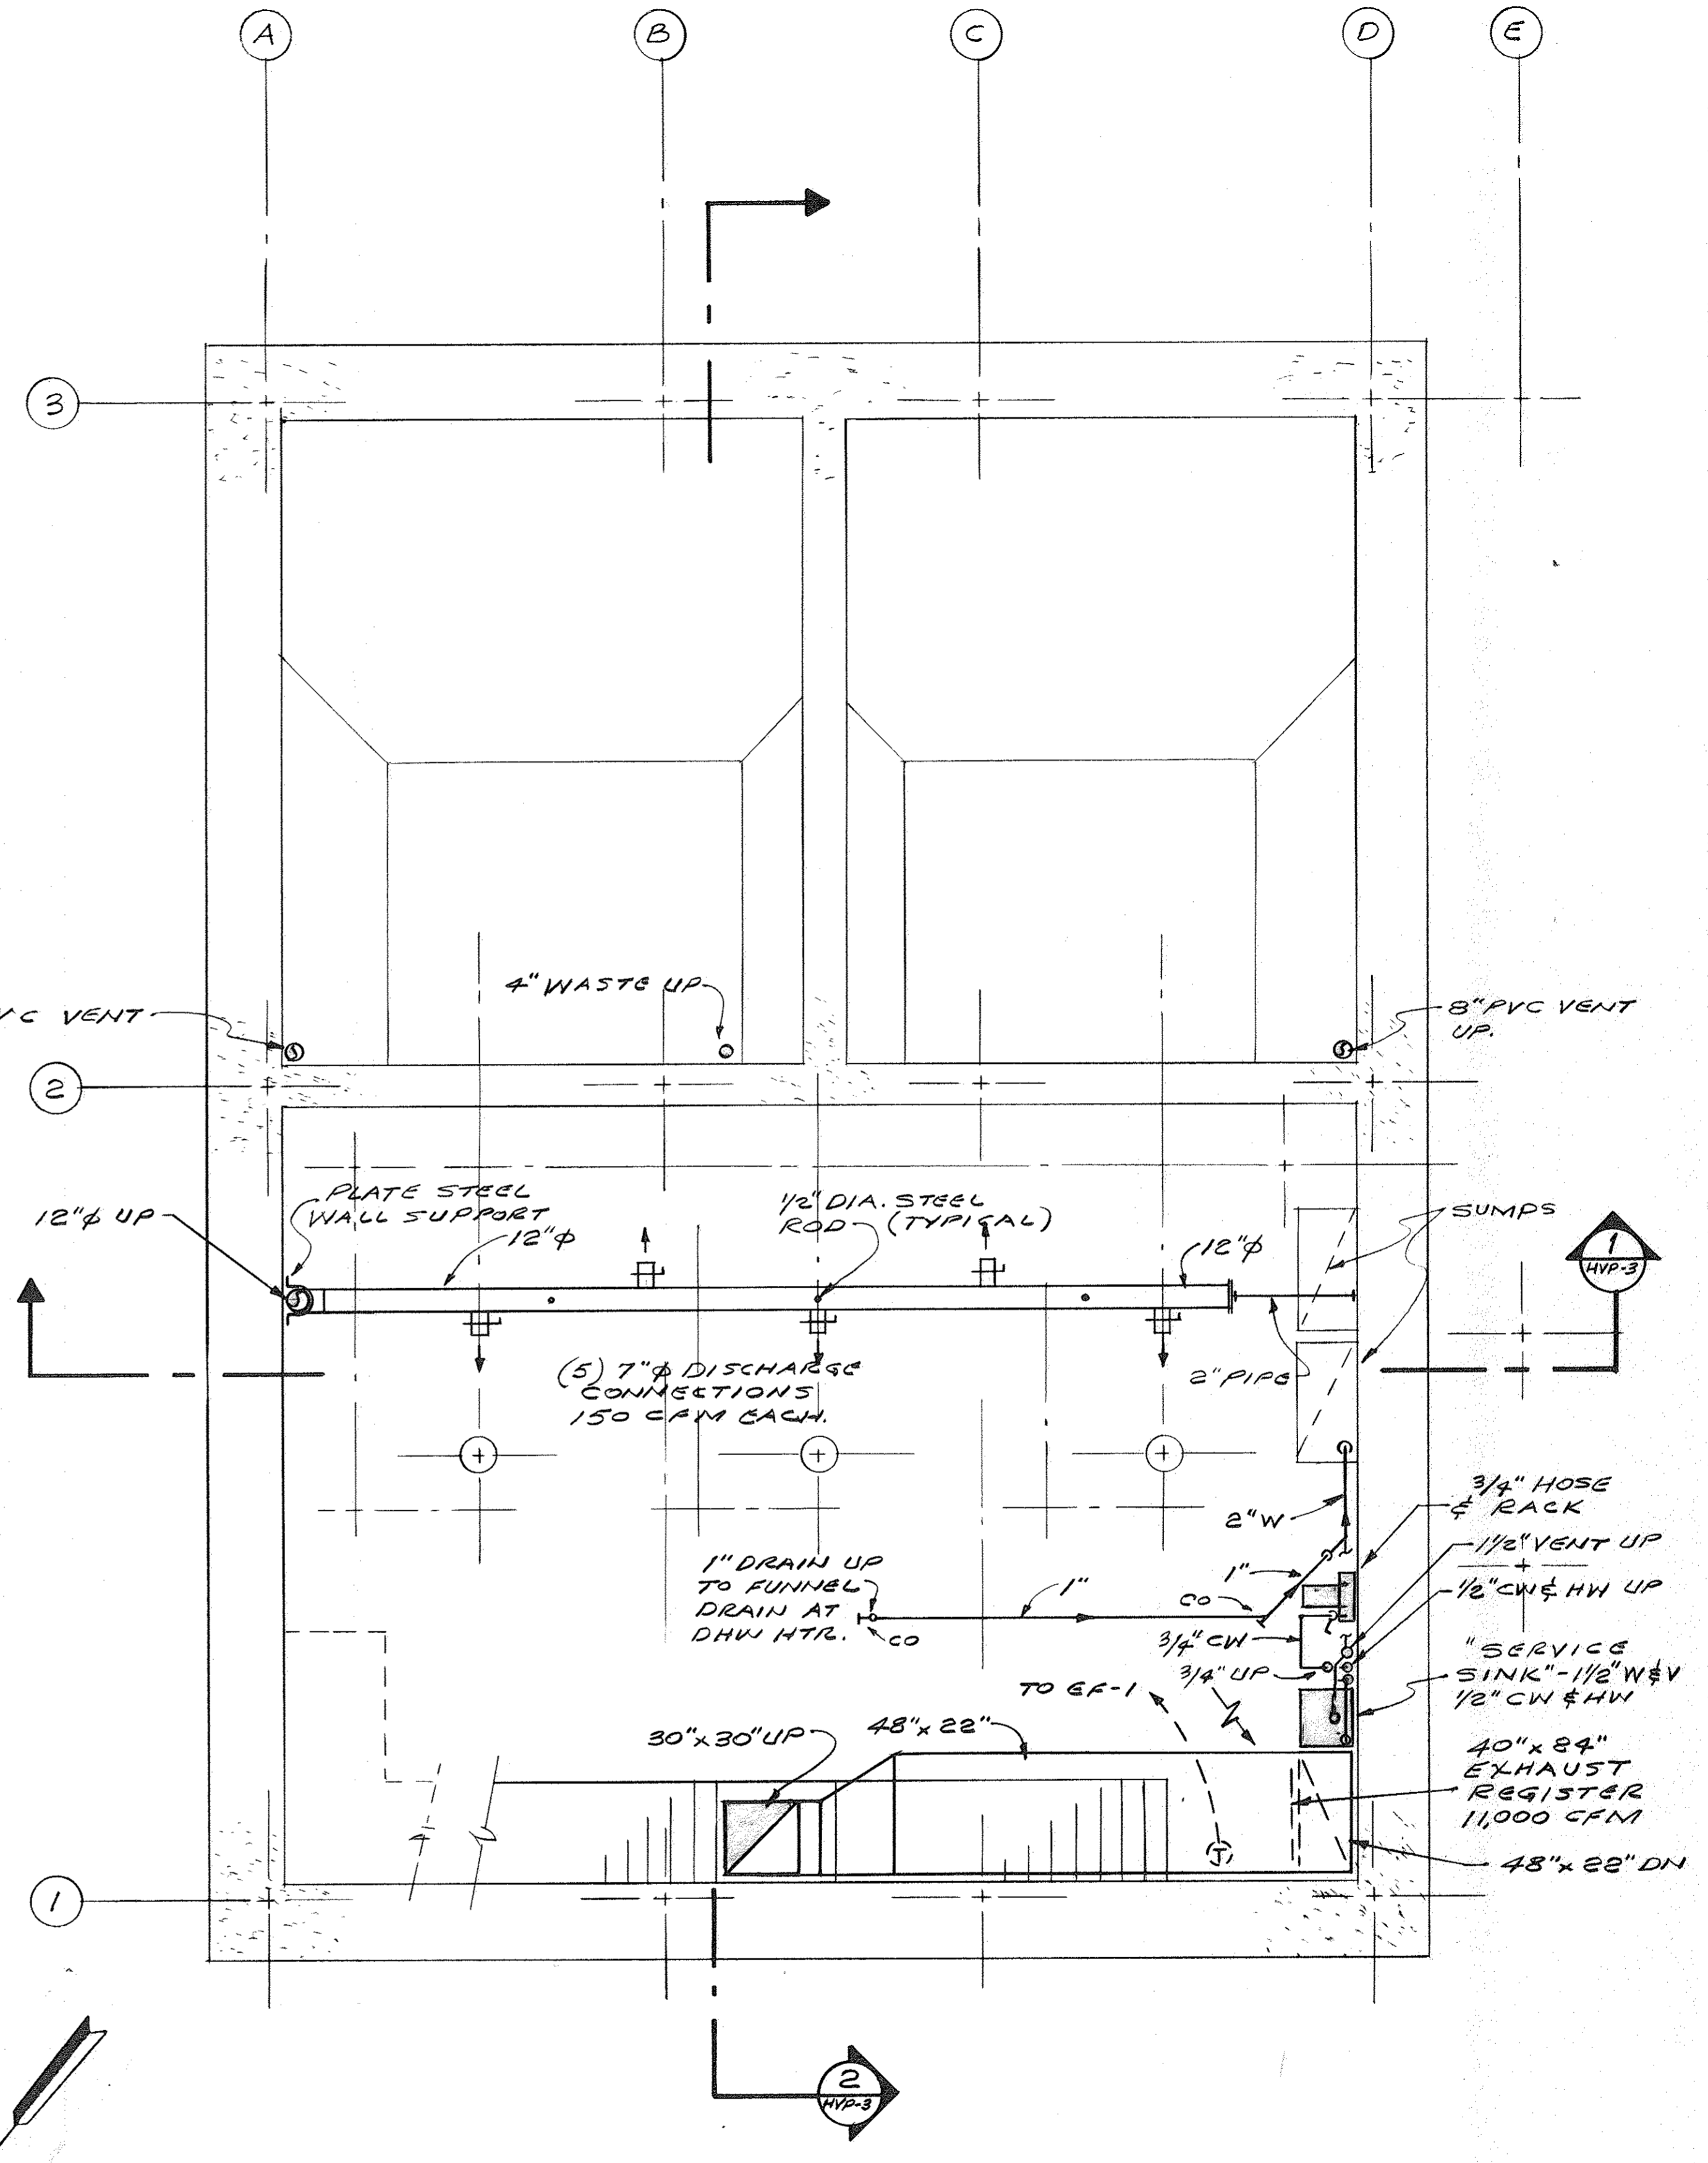



PLAN - INTERMEDIATE LEVEL
SCALE: 1/4" = 1'-0"

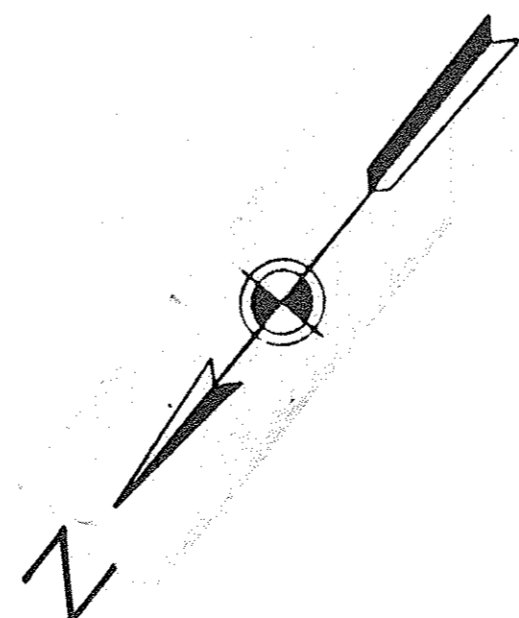

PLAN - LOWER LEVEL
SCALE: 1/4" = 1'-0"

NO.	DATE	DESCRIPTION
1	4/30/91	RECORD DRAWING

REGISTERED PROFESSIONAL ENGINEER
Peter M. Sampson

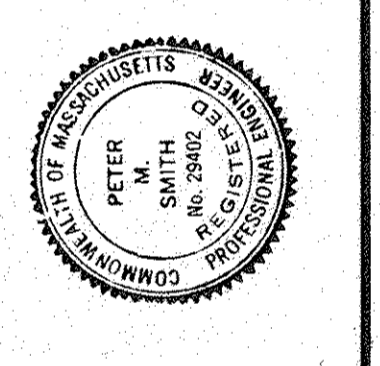

TOWN OF LEXINGTON, MASSACHUSETTS
DEPARTMENT OF PUBLIC WORKS
NORTH LEXINGTON MAIN PUMPING STATION

LOWER AND INTERMEDIATE LEVEL PLANS

CONTRACT NO. 92-1
JOB NO. 9065
SCALE: AS NOTED
DATE: 4/30/91

RECORD DRAWING

