

Name

Service No.

Address 1 ARDEN RD

McLAVELLEN

Location

Kind of Pipe

Size

Size of Main

Repair ~~Renewal~~ New Service

Location

Date

Material

Amount

Total

Date

Amount

1/20/18

6" SDR


6" CL

22" DWM

6" x 6" FURNIS

DATE 1/2018

TOWN OF LEXINGTON — BOARD OF PUBLIC WORKS
SEWER DIVISION

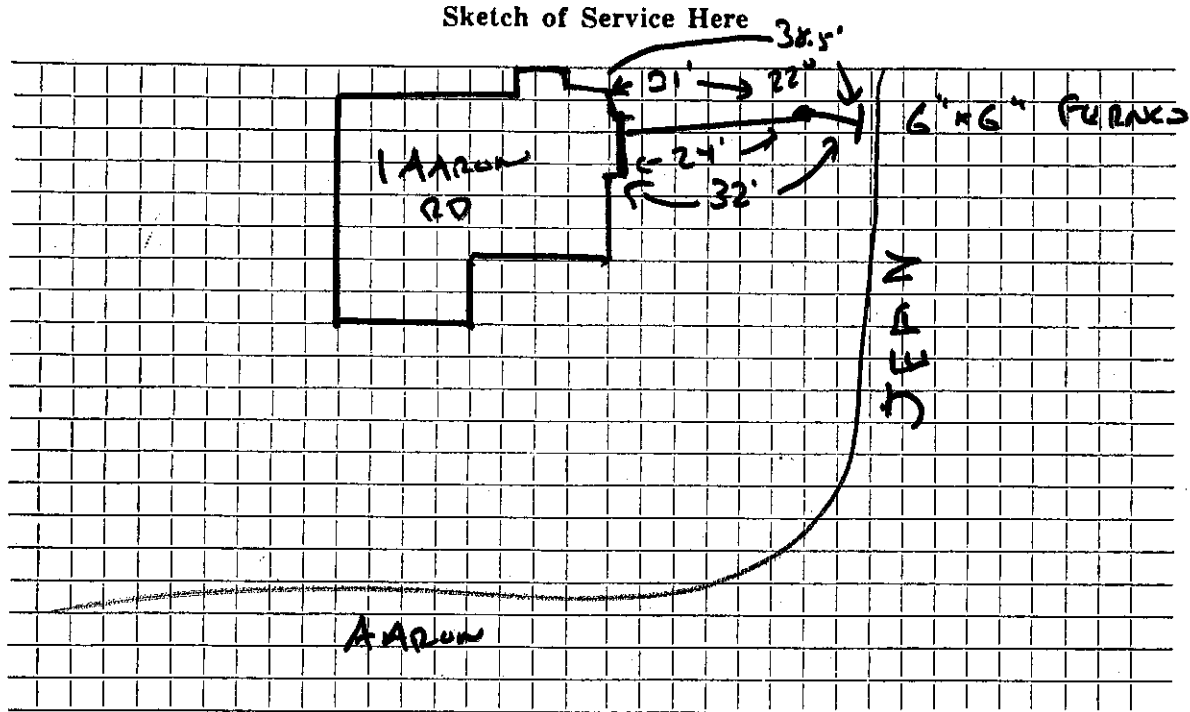

Connection made in ... JEAN ... Street. Work completed ... McLAUGHLIN ...

Remarks:

.....

.....