

Name Dr. Frank E. Wheatley, Jr.

Service No. 6

Address 3 Abbott Road

Location

Kind of Pipe

Size

Size of Main

~~RENEW~~ Renewal ~~NEW SERVICE~~ W.O. # 6068

Location

JUL 7 1969


Date		Material	Amount		Total		Date		Amount		
6/4/69		Labor	53	32			4-8-69	Deposit	475	00	
6/6/69		"	34	25			7-7-69	Retard	267	61	
6/9/69		"	11	88					267	39	
		10% O.H.	9	95	109	40					
	42'	6" Transite @ .88			36	96					
	1/2	Bag Cement 1.55				78					
	2	1 1/4 Bends 2.35			4	70					
	3	Yds. Loam 3.50			10	50	6/4/69	Labor	53	32	
	1	Ton hot top			5	80	6/8/69	"	39	88	
	4	Hrs. Shovel 6.50			26	00	6/9/69	"	11	88	
	3	" Trucking 3.00			9	00		20'	Transite .88	17	60
	1/2	" " 1.50				75		1/2	Bag Cement 1.55	4	78
	1/2	" Roller 3.00			1	50		1	90o Elbow	4	09
		Trailer			2	00		16"	Nipple	1	21
					207	39		3	Yds. Loam 3.50	10	50
								5	Ton hot top 5.80	29	00
								4	Hrs. Shovel 6.50	26	00
								0	Hrs. Trucking 3.00	18	00
								6	Hr. trucking 1.50	75	
								2	Hr. roller 3.00	1	50
								2	Trailer	2	00
										216	62

DATE _____

TOWN OF LEXINGTON — BOARD OF PUBLIC WORKS
SEWER DIVISION

3 ABBOTT
56000165

Sketch of Service Here

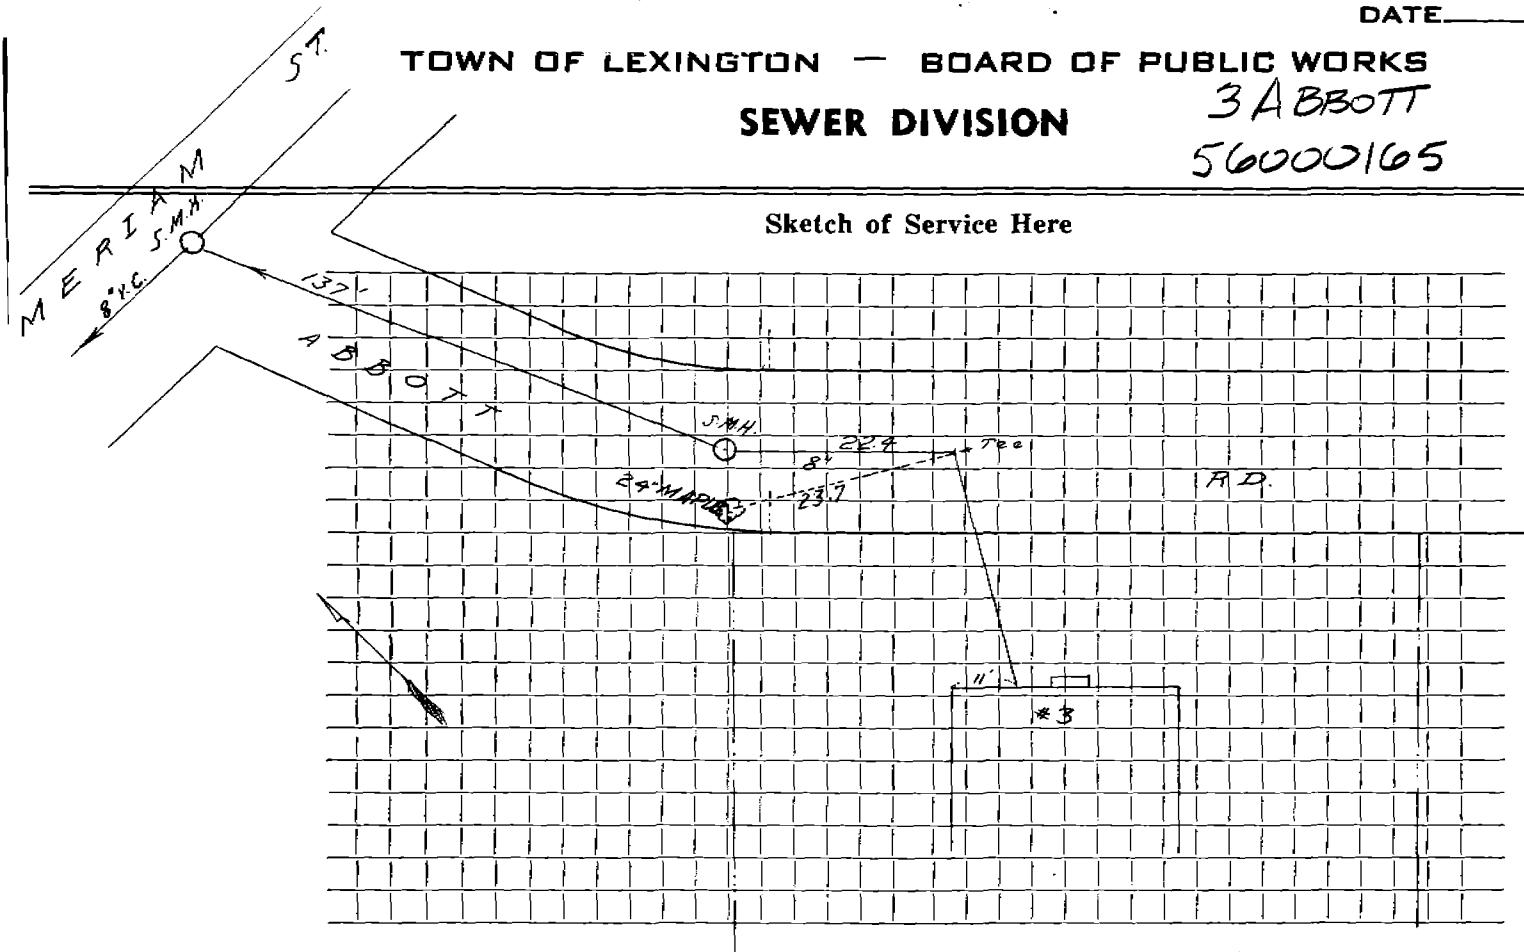

Connection made in Street. Work completed

Remarks: *9-2-26 original service 40'*

.....
.....