




DATE \_\_\_\_\_

TOWN OF LEXINGTON — BOARD OF PUBLIC WORKS

SEWER DIVISION

3 ABERNATHY RD  
30000127

Sketch of Service Here

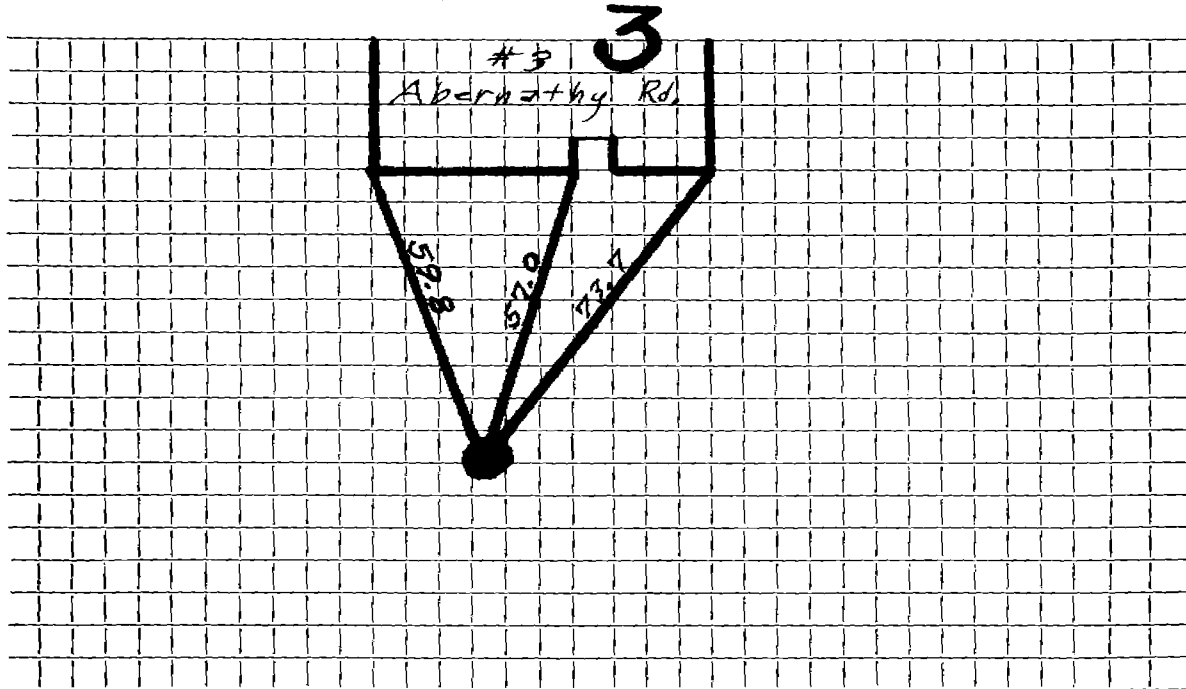

Connection made in ..... Street. Work completed .....

Remarks: .....

.....  
.....