

Name **Barney Tocio**

Service No. **138**

Address **5 Abernathy Road**

Location

Kind of Pipe

Size

Size of Main

~~Repair/Extend~~ **New Service**

W.O. #8244

Location

Comm 2-10-64

Date	Material	Amount	Total	Date		Amount
10-23-63	Labor	86.90		11-1-63	Deposit	200.00
	10% O.H.	8.69	95.59	2-10-64	Paid by W.H.C. #114	8.13
	72' 6" Transite pipe @.82		59.04			208.13
	40' 6" Transite pipe @.82		32.80			
	1 22 $\frac{1}{2}$ " Transite Elbow		2.35			
	1 11 $\frac{1}{4}$ " Transite Elbow		2.35			
	2 hrs. Compressor @5.00		10.00			
	2 hrs. Trucking @3.00		6.00			
	2 Services		208.13			


DATE _____

TOWN OF LEXINGTON — BOARD OF PUBLIC WORKS

SEWER DIVISION

5 ABERNATHY
30000 128

Sketch of Service Here

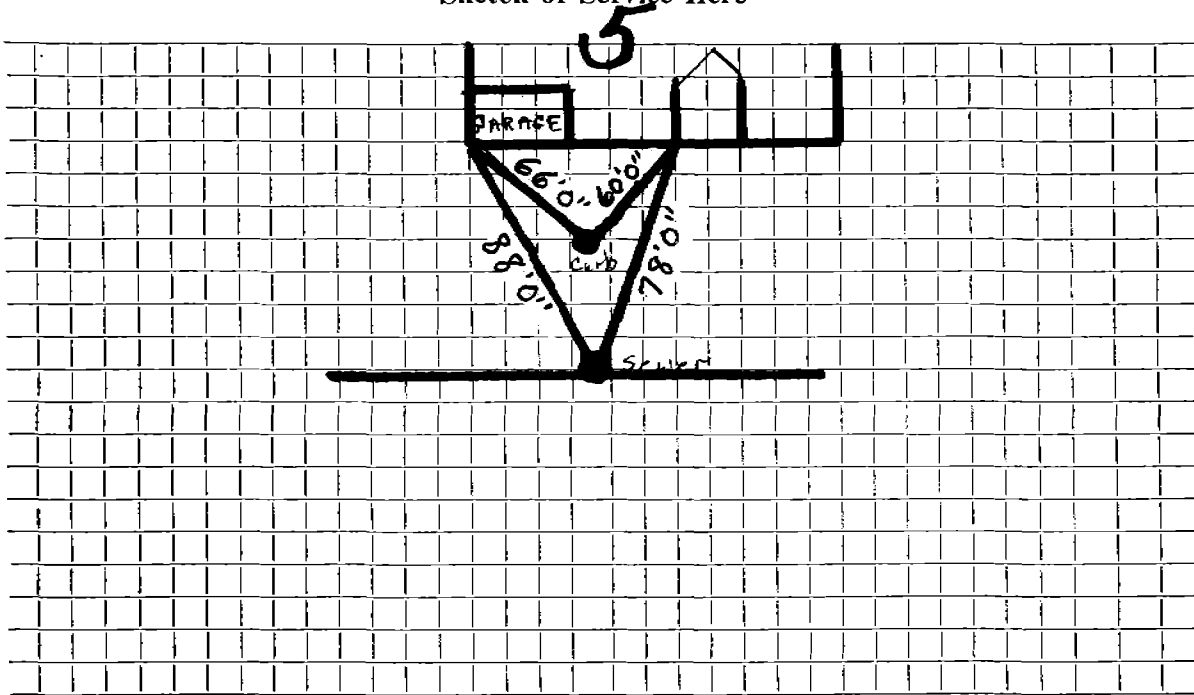

Connection made in Street. Work completed

Remarks:
.....
.....