

Name Moore Realty Trust

Service No. 124

Address 10 Adams Street

Location

Kind of Pipe

Size

Size of Main

REPAIRS—New Service


Location Conn 8-22-60

Date	Material	Amount	Total	Date	Amount
7-19-60	Labor	76 02		7-12-60	150 00
7-20-60	" "	52 13		8-22-60	7 37
		128 15		9-13-60	90 94
	10% O.H.	12 82	140 97		348 31
	63' 6" Transite pipe@.78		49 14		
	2 11 1/4" Transite bends		10 20		
	8 Hrs. Pippin shovel@4.50		36 00		
	4 Hrs. Trucking@3.00		12 00		
			248 31		

DATE _____

TOWN OF LEXINGTON — BOARD OF PUBLIC WORKS
SEWER DIVISION

Sketch of Service Here

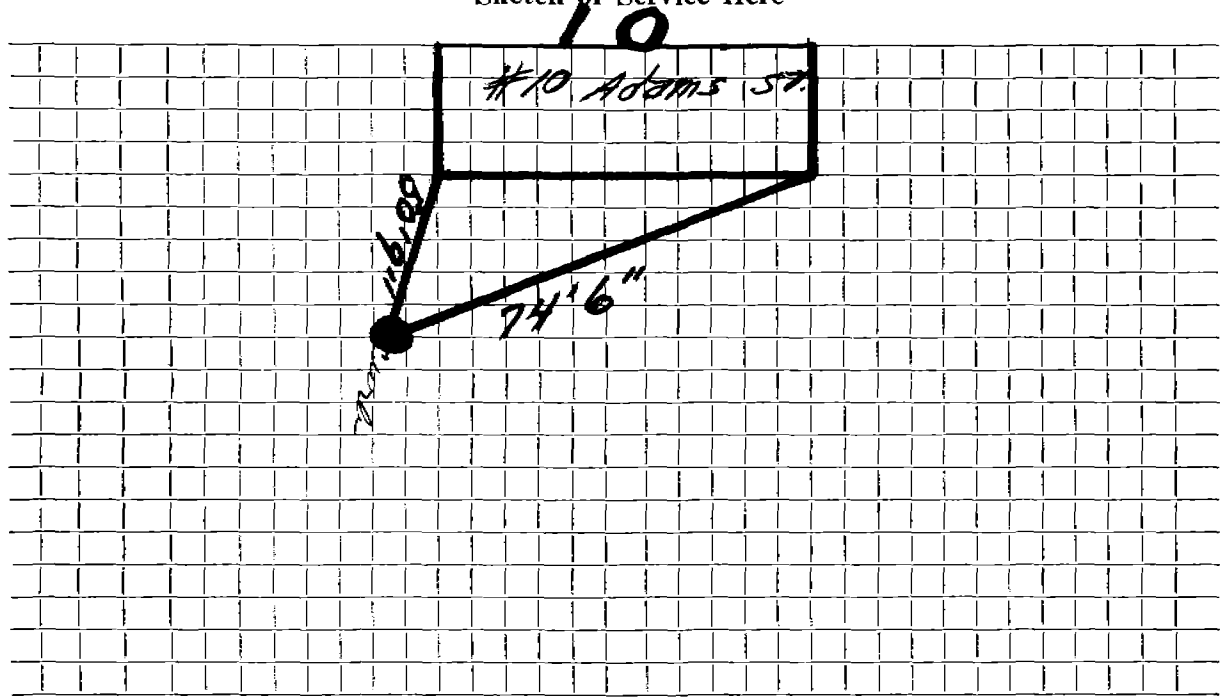

Connection made in Street. Work completed

Remarks:
.....
.....