

Name William H. Sullivan

Service No. 199

Address 11 Adams Street

Lot K

Location

Kind of Pipe Kirkland & Shaw Permit #195

Size

Size of Main


~~Renewal~~ New Service W.O. #9395

Location FEB 15 1965

Date	Material	Amount	Total	Date	Amount
12-15-64	Labor	81 20		12-4-64	125 00 <i>Deposit</i>
	10% O.H.	8 12	89 32	2-15-65	5 35 <i>Paid by W.O.#148</i>
	20' 6" Transite Pipe @.82		16 40	3-9-65	28 48 <i>Paid</i>
	1 90° Elbow		4 09		158 83
	1 20X3 Patch		20 00		
	4 Hrs. Town Shovel :6.50		26 00		
	1 Hr. Town Truck		3 00		
			<u>158 81</u>		

DATE _____

TOWN OF LEXINGTON — BOARD OF PUBLIC WORKS
SEWER DIVISION

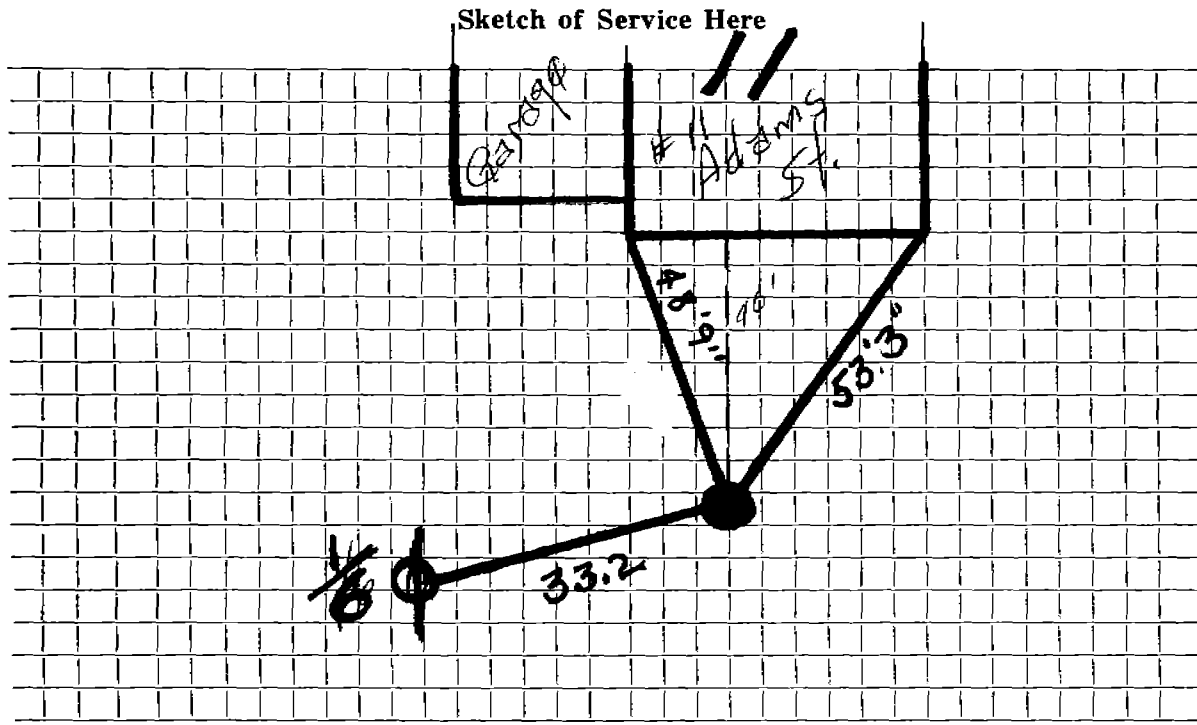

Connection made in Street. Work completed

Remarks:
.....
.....