

Name George Hurley

Service No. 15

Address 114 Adams Street

Location #13 Lot

Kind of Pipe

Size

Size of Main

Repair—Renewal—New Service Valeri #1831

Location JUL 26 1971

Date		Material	Amount	Total	Date	Amount
Dec. 1969	-	23' - 6" transite pipe @ 8.00	-	\$ 184 00	4-14-71	Deposit 184 00
4-21-71	30'	6" Transite Pipe				
	10'	4" Cast Iron Pipe				


H.B.M.18501

DATE _____

TOWN OF LEXINGTON — BOARD OF PUBLIC WORKS

SEWER DIVISION

Sketch of Service Here

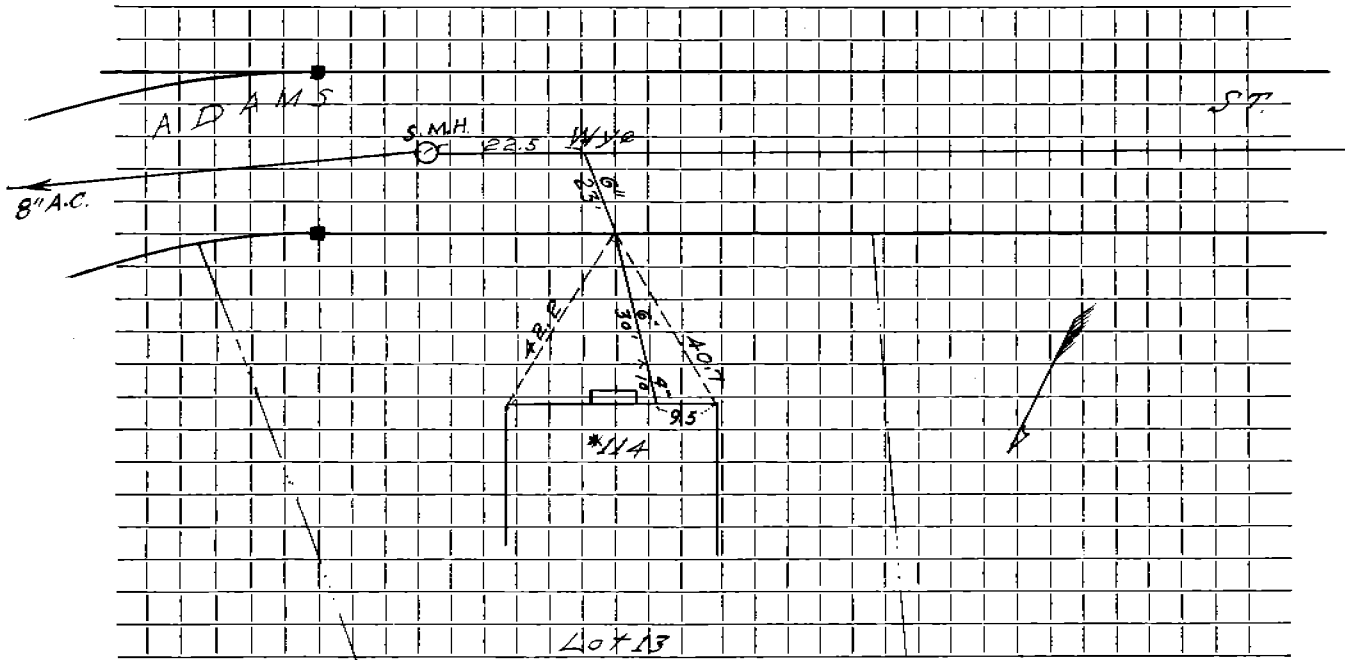

Connection made in Street. Work completed

Remarks:
.....
.....