


DATE _____

TOWN OF LEXINGTON — BOARD OF PUBLIC WORKS
SEWER DIVISION

Sketch of Service Here

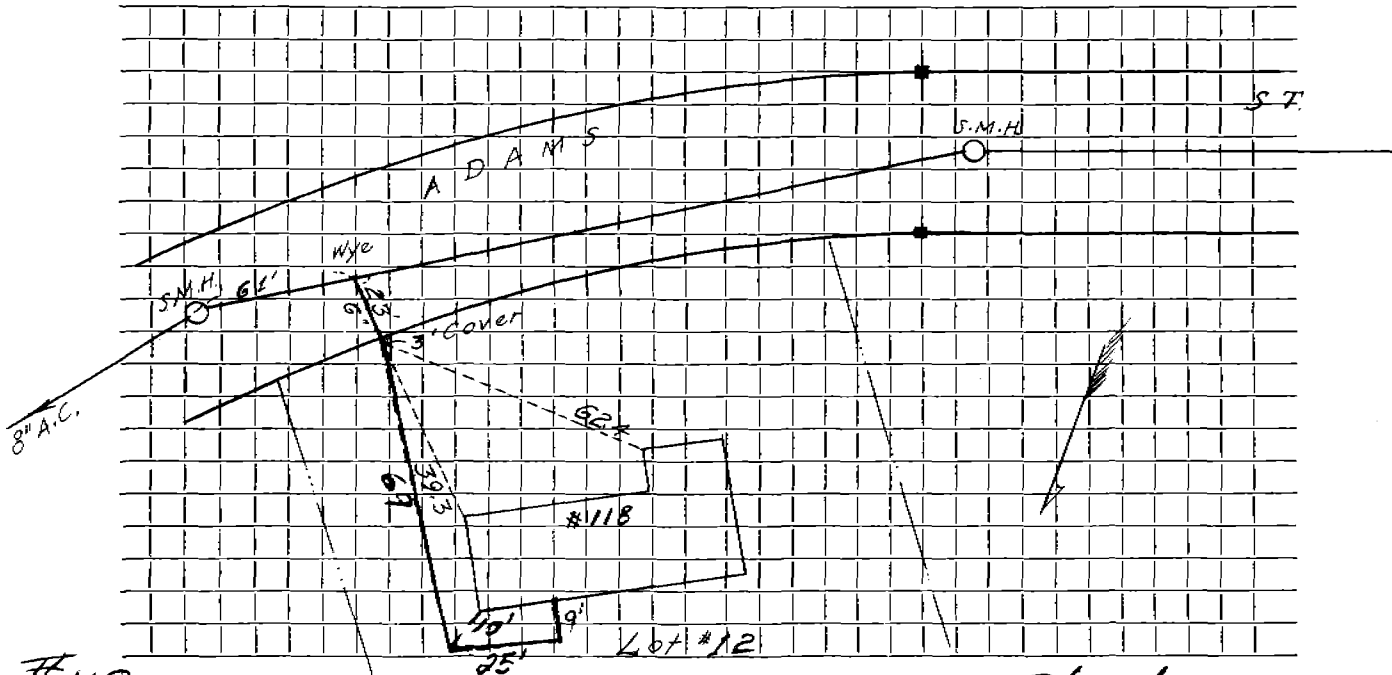

Connection made in #118 ADAMS ST Street. Work completed 8/26/75

Remarks:

.....

.....