

Name Barle Burke Jr.

Service No.

38

Address 132 Adams Street

#132 ADAMS STREET

Location

Kind of Pipe

Size

Size of Main

Repair—Renewal—New Service ADO & Son # 1040

Location AUG 5 1968


Date		Material	Amount	Total	Date	Amount	
1967	25'	6" Transite pipe @6.00		150.00	5-23-68	Deposit	150 00
5/23/68	8'	4" Cast Iron					
	59'	6" Transite Pipe					

DATE _____

TOWN OF LEXINGTON — BOARD OF PUBLIC WORKS

SEWER DIVISION

Sketch of Service Here

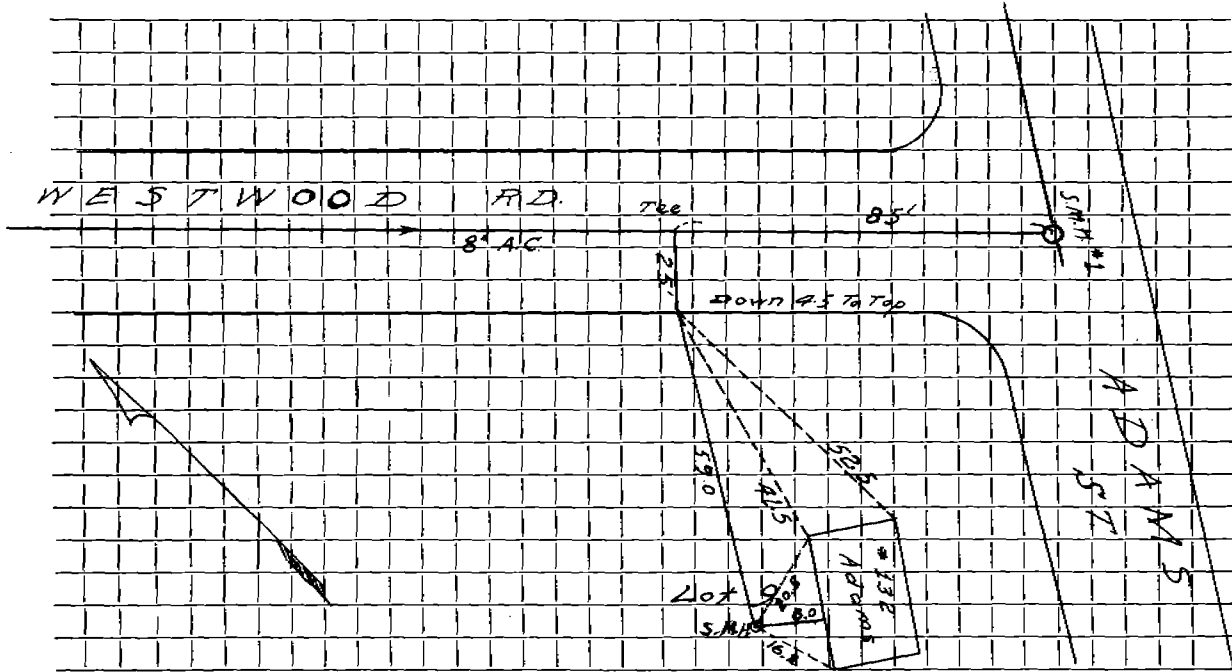

Connection made in Street. Work completed

Remarks:
.....
.....