


TOWN OF LEXINGTON - BOARD OF PUBLIC WORKS
 WATER DIVISION

Date: 5/2021

SKETCH OF SERVICE HERE

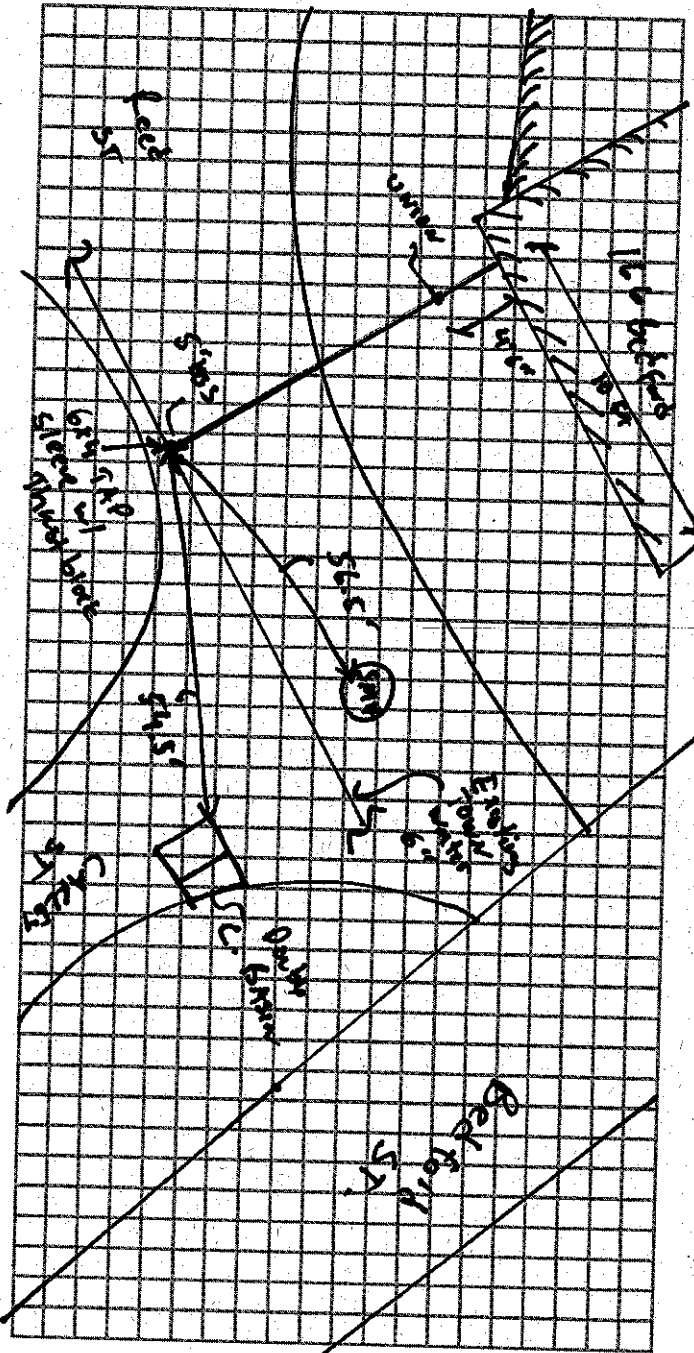

Connection made in: feet st

Street:

Work completed:

Remarks:

Gasline present for pressure & chlorine test (PASSED)

Address 166 Bedford St

Location

Repair - Renewal New Service

Date	Material	Amount	Total	Date		Ar
5/2021	6x4" Ductile Iron Tee	①				
	6" D.I Pipe	~ 60 ft				
	Union / Restraint Ties					
	Thrust block @ Town connection					