

WATER SERVICE RECORD

Name **Esco Builders**

Service No. **25**

Address **7 Abernathy Road**

2087

Location

~~Repair~~ **New Service**

WO # **8644**

JUN 29 1964

Date	Material	Amount	Total	Date		Amount
5/18/64	Labor	2 42		4-9-64	Deposit	50 00
	10% O.H.	24	2 66	6-29-64	* Retard	13 56
60'	3/4" Copper Tubing @ .42		25 20			36 44
1	3/4" Cx 1/2 I.W.H. Stop & Waste		6 17			
1	3/4" C3 Part Union		2 41	5/18/64	1 1/2 Offset Tailpiece	50
			36 44		1 1/2 Straight Tailpiece	50
						1 00


* Apply 3.14 to ~~25~~ **24**

DATE _____

TOWN OF LEXINGTON — BOARD OF PUBLIC WORKS

WATER DIVISION

Sketch of Service Here

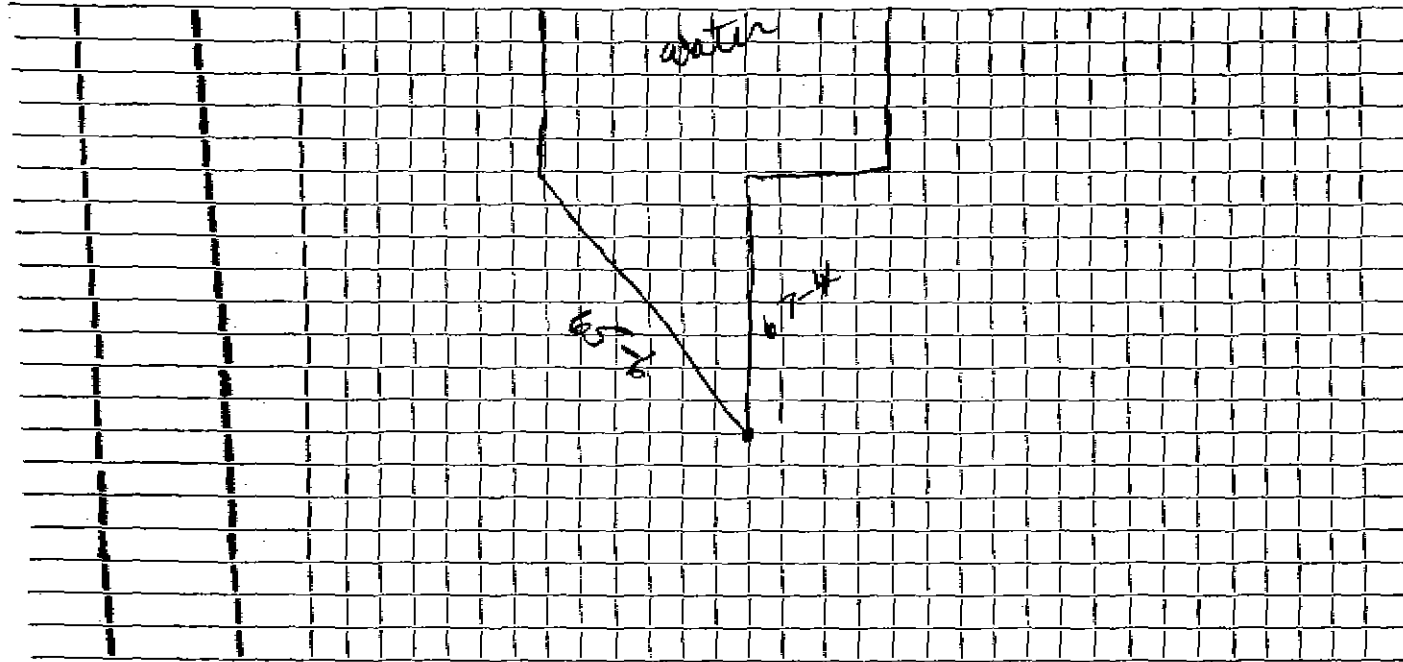

Connection made in _____ Street. Work completed _____

Remarks: _____

