

WATER SERVICE RECORD

#5142

Name Rocco DeAmicas
 Address 107 Adams Street

Service No. 124

Location

~~x Repair~~ ~~x Removal~~ - New Service

Comm. 9/30/57


Date	Material	Amount	Total	Date	Amount
7/1/57	Labor	30 81		6-26-57	Deposit \$ 125 00
	10% overhead	3 08	33 89	9-30-57	Refund 28 82
	54' - 3/4" Copper tubing @ .4228	22 83			NON CHARGE \$ 96 18
	1 - 3/4" Cx 1/2 I.W.H. Stop & Waste	4 96		Labor	15 39
	2 hrs. Trucking @ .75		1 50	27' - 3/4" Copper tubing @ .4228	11 42
	2 hrs. Town Shovel @ 6.50		13 00	1 - 3/4" C. Corp Cock	4 64
	20x3 Patch		20 00	1 - 3/4" C. Curb Cock	5 94
			96 18	1 Box & Rod	4 62
				1 - 1/2 Straight tailpiece	50
				1 - 1/2 Offset tailpiece	50
				1 hr. Town Shovel	6 50
				1 hr. Trucking	75
					50 26

DATE _____

TOWN OF LEXINGTON — BOARD OF PUBLIC WORKS

WATER DIVISION

Sketch of Service Here

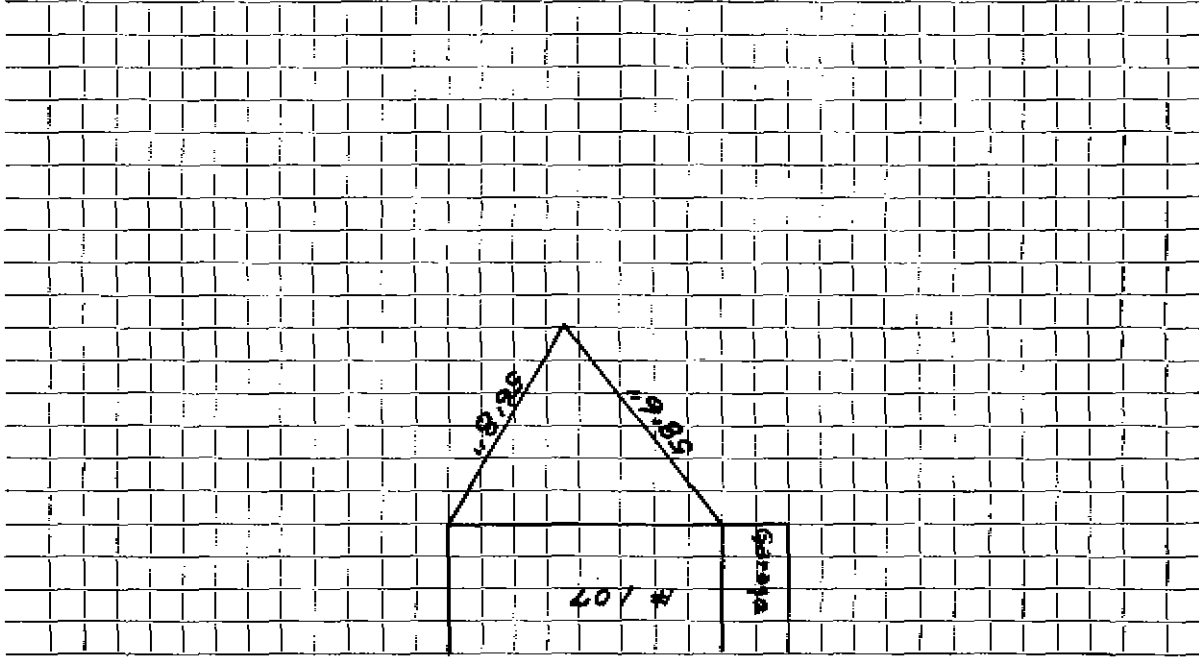

Connection made in _____ Street. Work completed _____

Remarks: _____