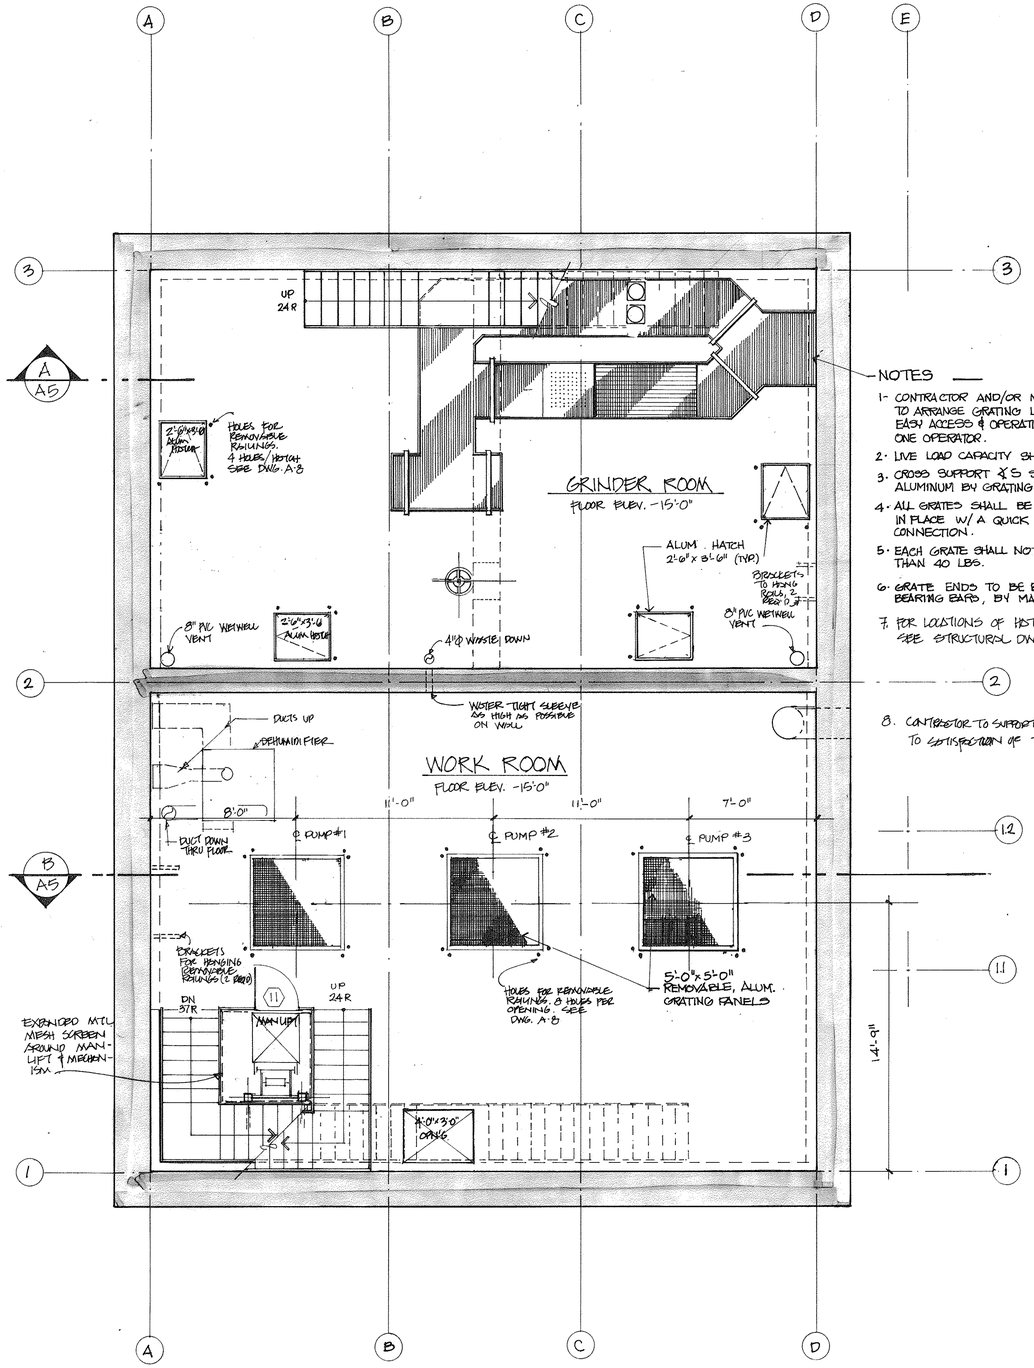

PLAN - INTERMEDIATE LEVEL

NOTES

1. CONTRACTOR AND/OR MANUFACTURER TO ARRANGE GRATING LAYOUT TO ALLOW EASY ACCESS & OPERATION BY ONE OPERATOR.
2. LIVE LOAD CAPACITY SHALL BE 250 LBS/S.F.
3. CROSS SUPPORT ∠'S SHALL BE ALUMINUM BY GRATING MANUFACTURER.
4. ALL GRATES SHALL BE FASTENED IN PLACE W/ A QUICK RELEASE CONNECTION.
5. EACH GRATE SHALL NOT WEIGH MORE THAN 40 LBS.
6. GRATE ENDS TO BE BANDED W/ ALUM. BEARING BARS, BY MANUFACTURER.
7. FOR LOCATIONS OF HATCHES & TROUGHS, SEE STRUCTURAL DWGS.
8. CONTRACTOR TO SUPPORT ALL OPENINGS TO SATISFACTION OF THE ENGINEER

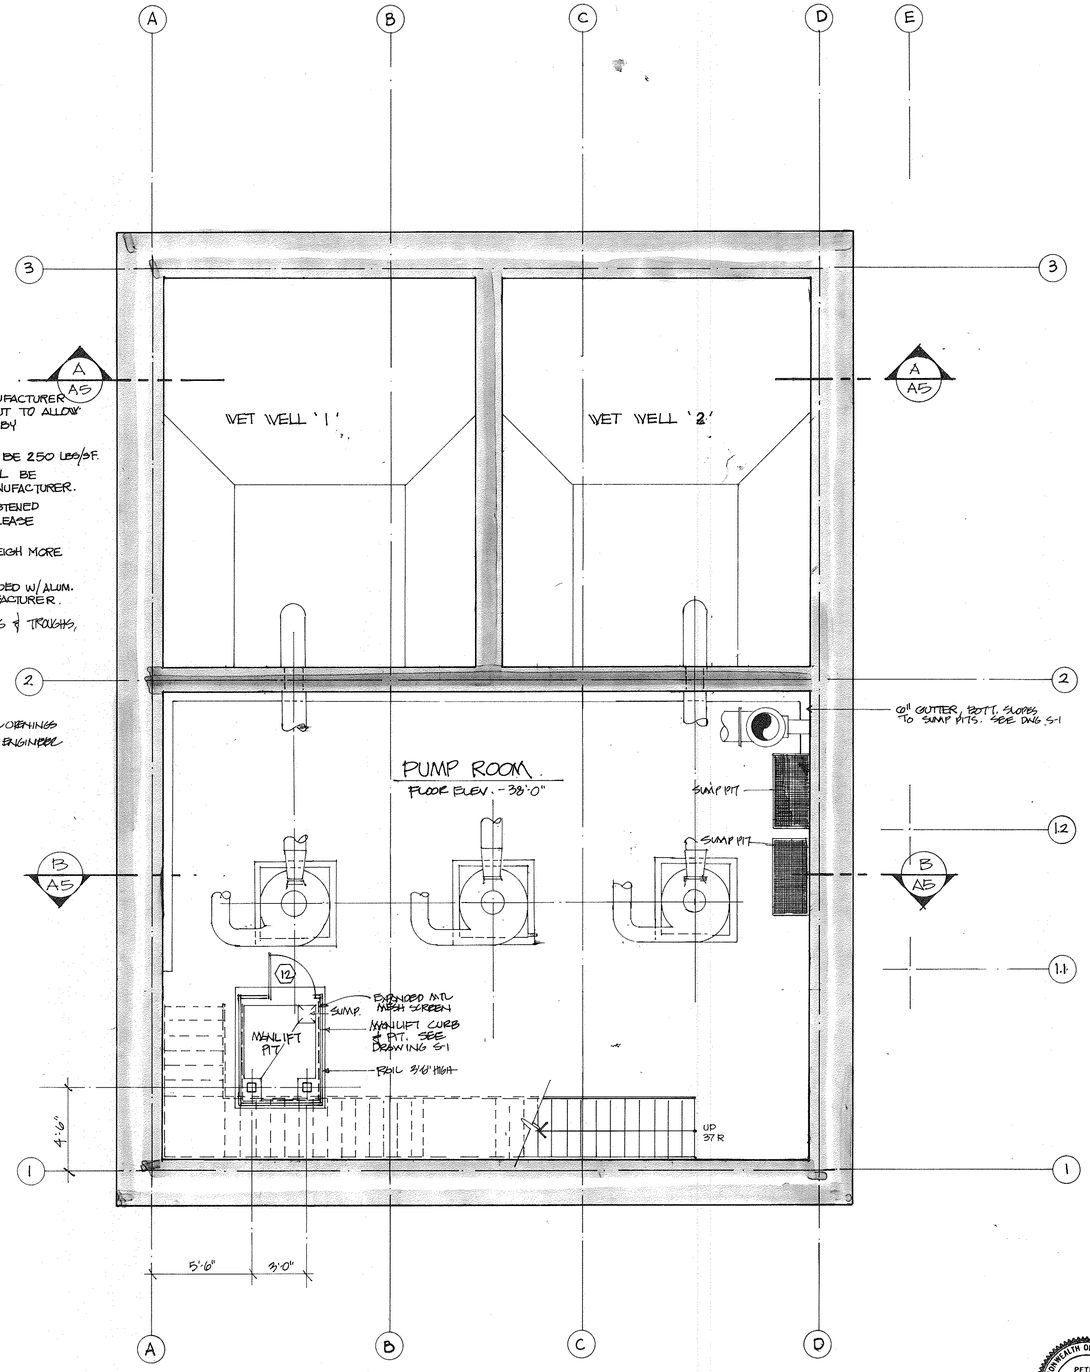

PLAN - LOWER LEVEL

NOTE: PUMPS & PIPING SHOWN ARE DIAGRAMATIC ONLY. FOR ACCURATE LOCATIONS, ELEV. ETC. SEE MECHANICAL DWGS.

COMMONWEALTH OF MASSACHUSETTS PETER M. SMITH No. 29402 REGISTERED PROFESSIONAL ENGINEER

CALLED NORTH

RECORD DRAWING

Weston & Sampson ENGINEERS, INC.
Five Centennial Drive, Peabody, MA 01960-7906

No.	Date	Dr. By	Ck. By	App. By	Description
1	5/95	RWS	MLM	PNY	RECORD DRAWING

A P P R O V E D

Peter M. Smith
REGISTERED PROFESSIONAL ENGINEER

4/30/91
DATE

TOWN OF LEXINGTON, MASSACHUSETTS
DEPARTMENT OF PUBLIC WORKS
NORTH LEXINGTON MAIN PUMPING STATION
INTERMEDIATE AND LOWER LEVEL PLANS

SCALE: 1/4"=1'-0"	CONTRACT 92-1	JOB NO. 30065	DR. BY RL	CK. BY EBS	APP. BY EBS
CADD NO.					

A-1

FILE NO. 69-56

SHEET 9 OF 42

192717
MILLER REPROGRAPHICS CO., INC.