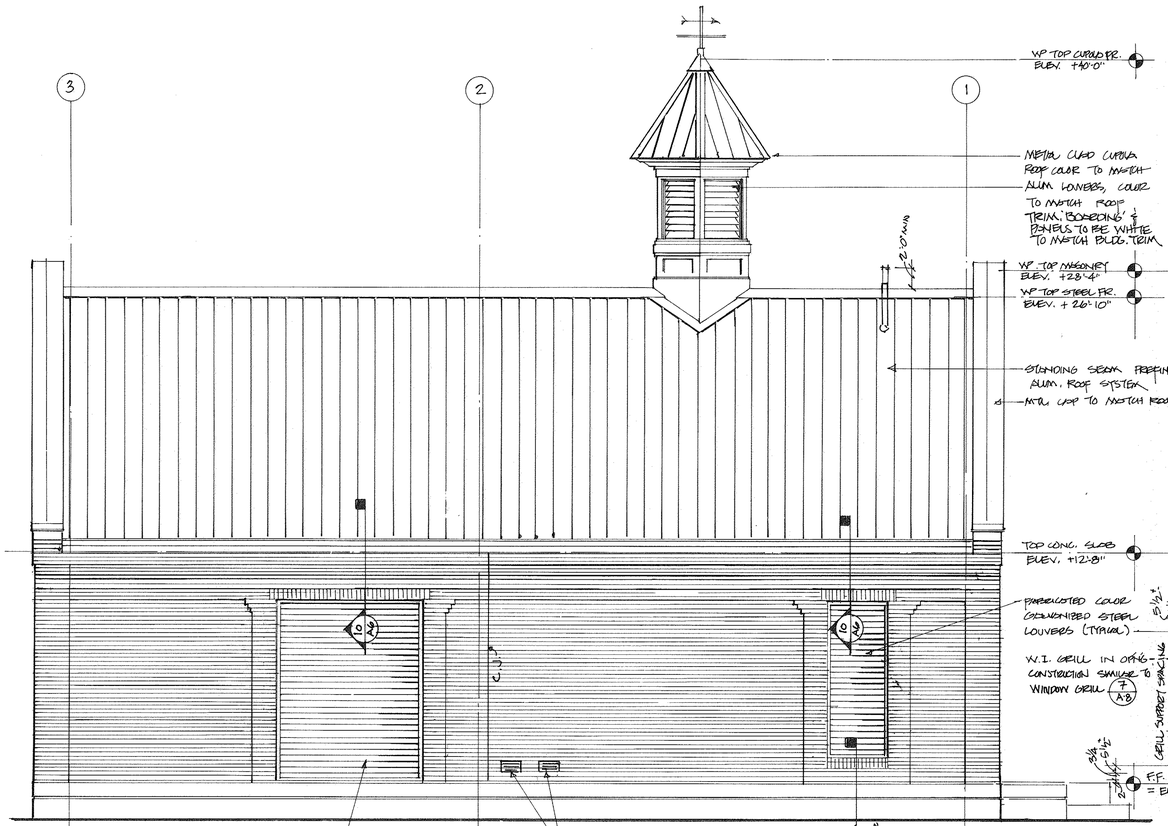

RECORD DRAWING

No.	Date	Dr. By	Ck. By	App. By	Description
1	5/95	RWS	MJM	FWY	RECORD DRAWING

A P P R O V E D

4/30/91
DATE

REGISTERED PROFESSIONAL ENGINEER

Weston & Sampson
ENGINEERS, INC.
Five Centennial Drive, Peabody, MA 01960-7906

TOWN OF LEXINGTON, MASSACHUSETTS
DEPARTMENT OF PUBLIC WORKS
NORTH LEXINGTON MAIN PUMPING STATION

BUILDING ELEVATIONS

CADD NO.	SCALE: 1/4"=1'-0"	CONTRACT 92-1	JOB NO. 9365	DR. BY	CK. BY FDS	APP. BY FDS

FILE NO. 69-53

A-4

SHEET 12 OF 42

COMMONWEALTH OF MASSACHUSETTS
PETER M. SMITH
No. 29402
REGISTERED PROFESSIONAL ENGINEER

192717

MILLER REPROGRAPHICS CO., INC.