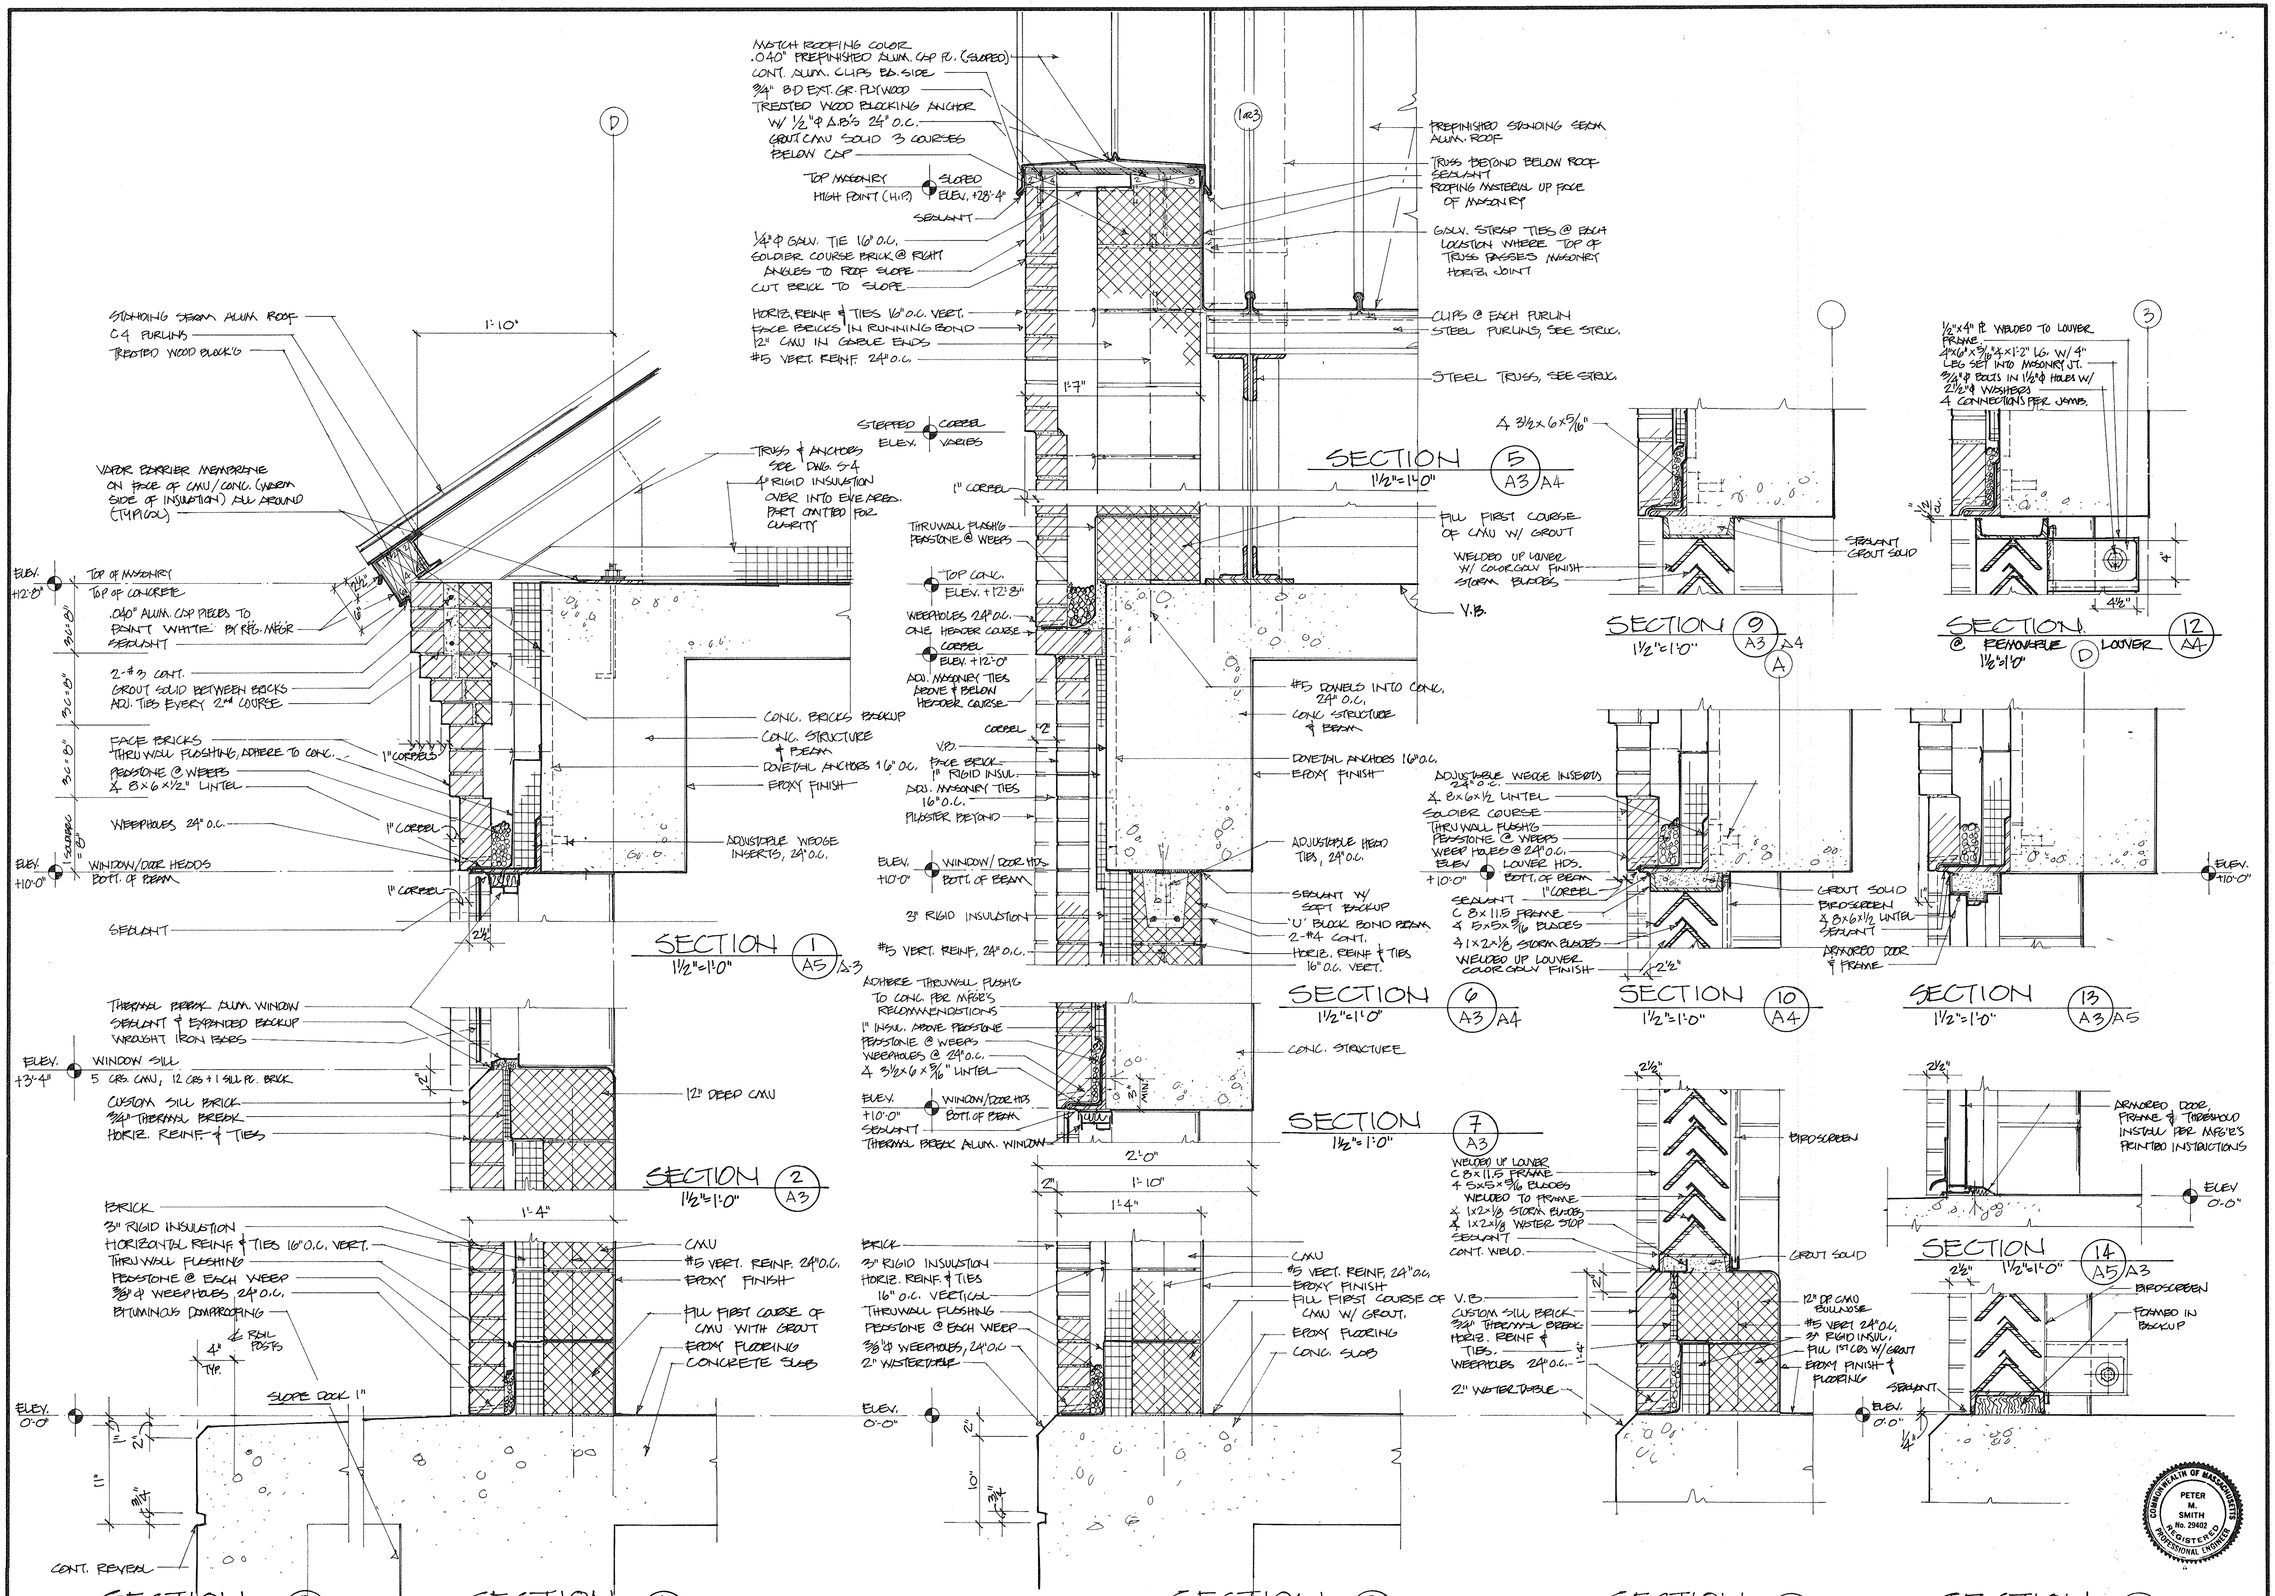

Weston & Sampson
ENGINEERS, INC.
Five Centennial Drive, Peabody, MA 01960-7906

No.	Date	Dr. By	Ck. By	App. By	Description
1	5/95	RJS	MJM	FNY	RECORD DRAWING
A		P	P	R	O V E D

4/30/91
DATE

Peter M. Smith
REGISTERED PROFESSIONAL ENGINEER

COMMONWEALTH OF MASSACHUSETTS
PETER M. SMITH
No. 29402
REGISTERED PROFESSIONAL ENGINEER

TOWN OF LEXINGTON, MASSACHUSETTS
DEPARTMENT OF PUBLIC WORKS
NORTH LEXINGTON MAIN PUMPING STATION

VERTICAL WALL SECTIONS

SCALE: 1½"=1'0"	DR. BY	CK. BY	APP. BY
JOB NO. 9065		EDS	EDS
CONTRACT 92-1			
CADD NO.			

A-6

FILE NO. 69-51

SHEET 14 OF 42

RECORD DRAWING

152717
MILLER REPROGRAPHICS CO., INC.