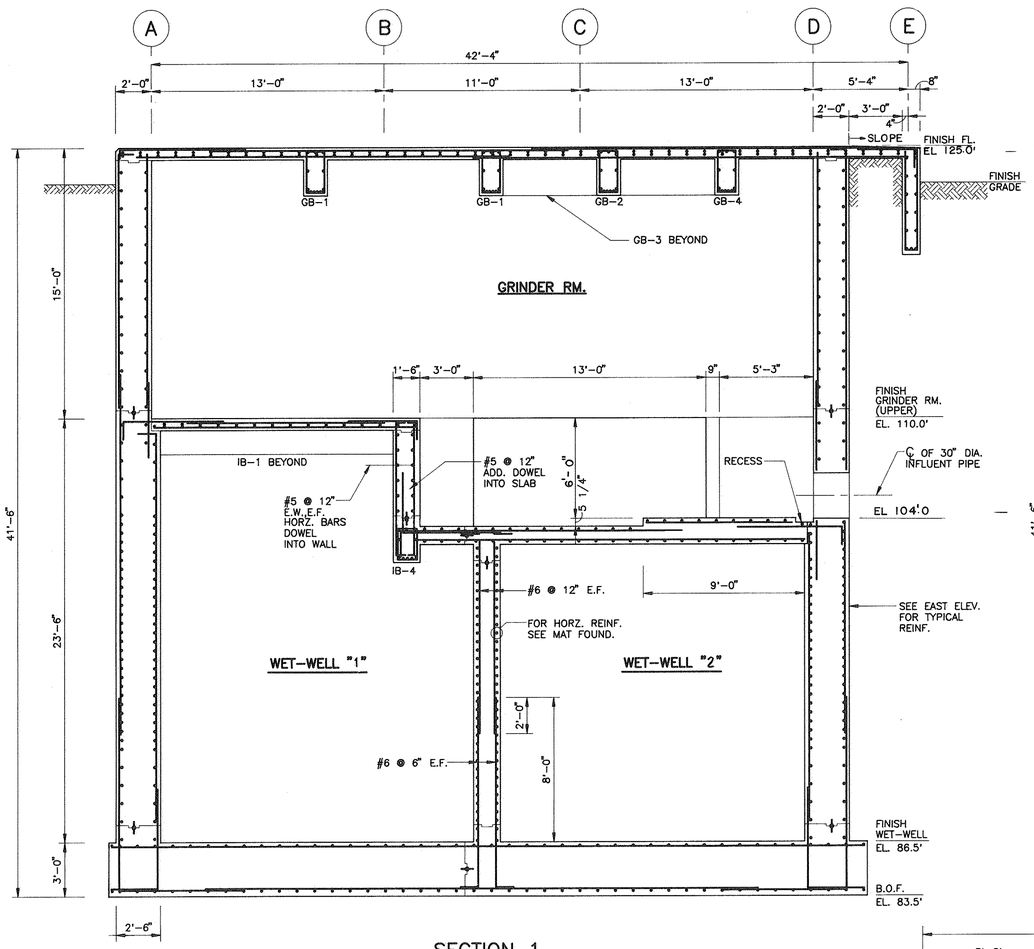

SECTION 1
SCALE: 1/4"=1'-0"

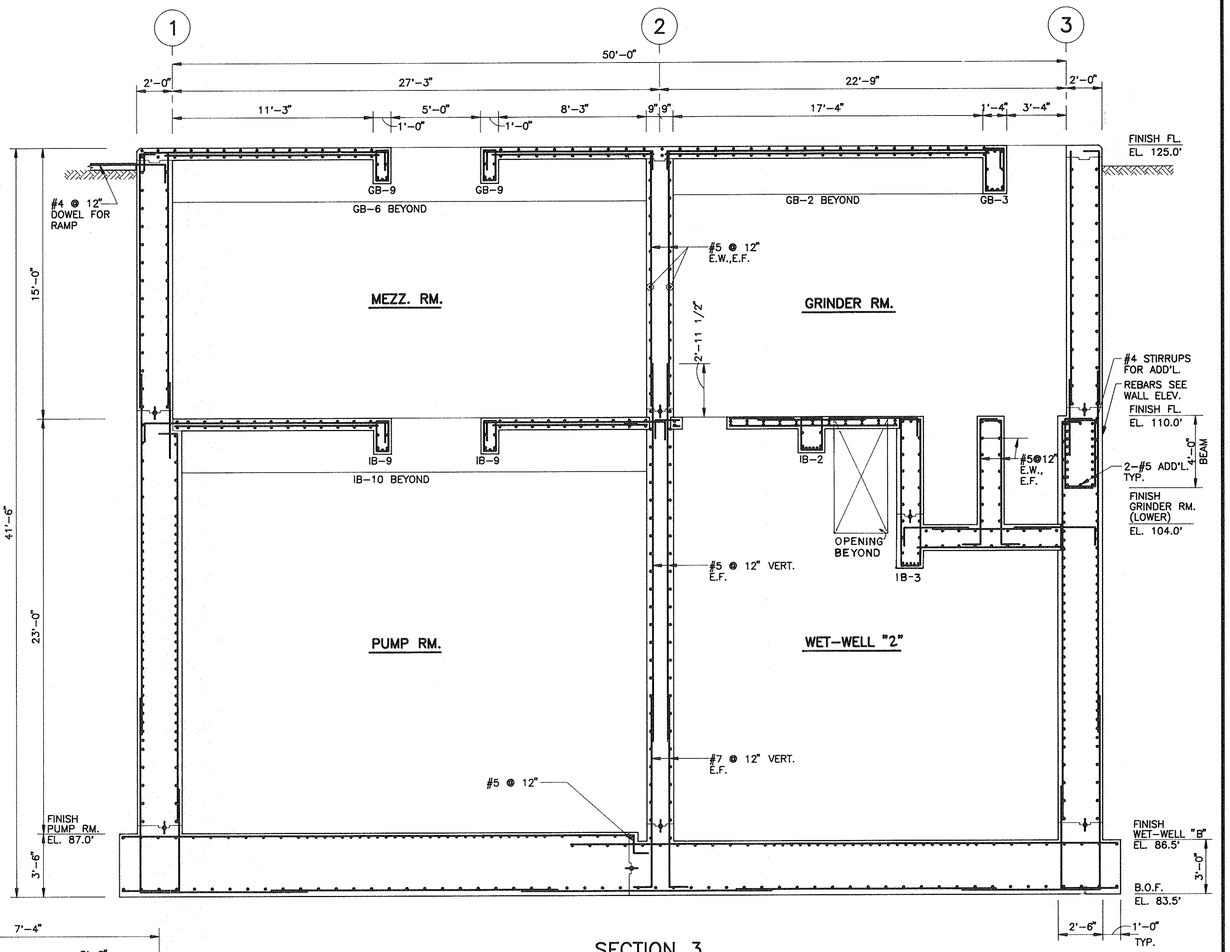

SECTION 3
SCALE: 1/4"=1'-0"

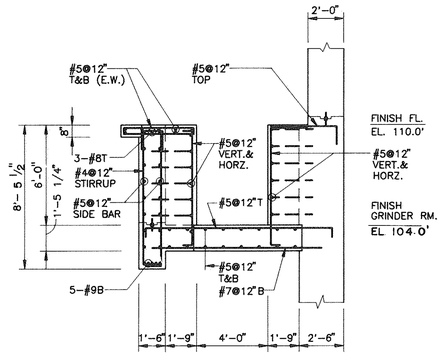

SECTION 2
SCALE: 1/4"=1'-0"

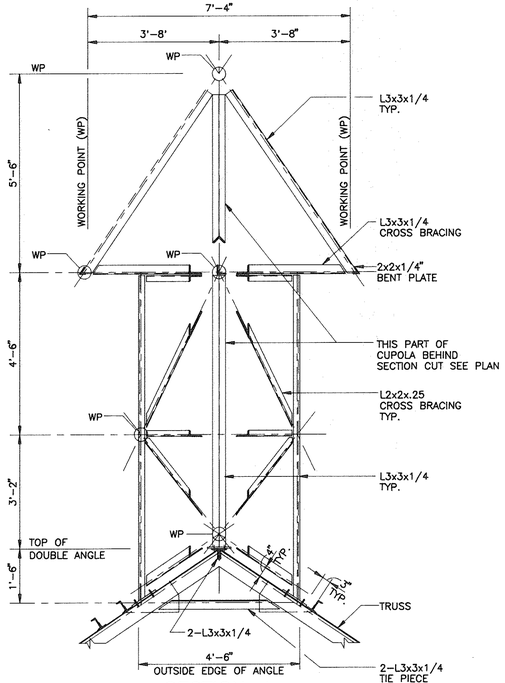

SECTION 4
SCALE: 1/2"=1'-0"

RECORD DRAWING

LIN ASSOCIATES, INC.
2001 BEACON STREET
BOSTON, MA 02146

Weston & Sampson
ENGINEERS, INC.
Five Centennial Drive, Peabody, MA 01960-7906

No.	Date	Dr.By	Ck.By	App.By	Description
1	5/95	RNS	WJM	FWY	RECORD DRAWING

1/15/97
DATE

REGISTERED PROFESSIONAL ENGINEER

TOWN OF LEXINGTON, MASSACHUSETTS
DEPARTMENT OF PUBLIC WORKS
NORTH LEXINGTON MAIN PUMPING STATION

BUILDING SECTIONS

CADD NO.	SCALE:	CONTRACT:	JOB NO.	DR.BY	CK.BY	APP.BY
P90028/SEC1	AS NOTED	92-1	9065	VVS	JRL	RSL

S-8

FILE NO 69-41

SHEET 24 OF 42