Name Harold Goldberg **Service No.** 45

Address 10 Alcott Road

Location

Kind of Pipe A.C. **Size** 6" **Size of Main** 8"

~~Repair Renewal~~ **New Service** Valeri #4482 **Location** FEB 27 1984

Date		Material	Amount		Total		Date			Amount	
7/12/77	25'	6" ACP @ $10.00			250.	00	10-4-83		Deposit	250	00
10/24/83	137'	x 6" P.V.C.									
	3	22½° Elbows									
	1	6" Wye									
	1	P.C.V. x A.C.P. Adaptor									
	1	6" x 4" Donut									
	200	Red Sewer Brick W/Frame & Cover									

DATE_____

TOWN OF LEXINGTON — BOARD OF PUBLIC WORKS

SEWER DIVISION

Sketch of Service Here

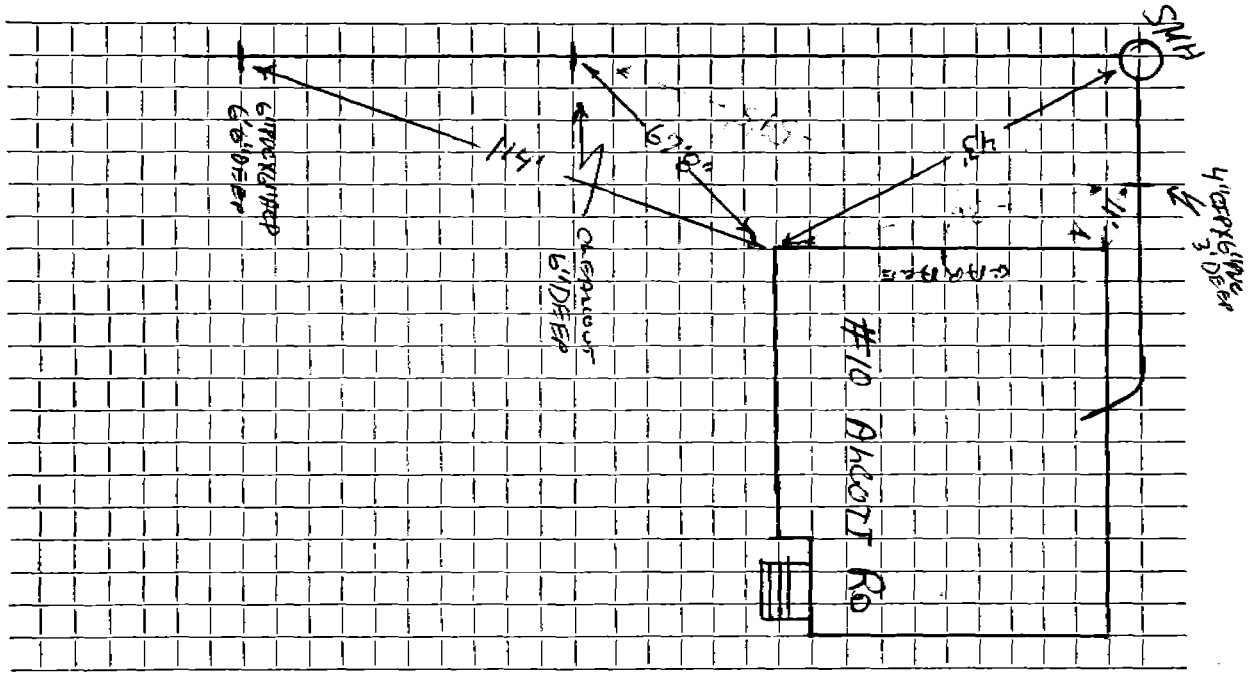

Connection made in ..... Street. Work completed .....

Remarks: .....

.....

.....