Name *Paul Paone* **Service No.** *23*

Address *58 Allen Street*

Location

Kind of Pipe **Size** **Size of Main**

~~Repair Renewal~~ **New Service** *Kirkland #3833* **Location** OCT 31 1983

Date		Material	Amount	Total	Date		Amount
4/29/83	*21'*	*6" PVC Pipe @ $16.00*		*336. 00*	*7-25-83*	*Deposit*	*336 00*
8/2/83	*78'*	*6" PVC*					
		6" x 4" Donut					

DATE _____

TOWN OF LEXINGTON — BOARD OF PUBLIC WORKS

SEWER DIVISION

Sketch of Service Here

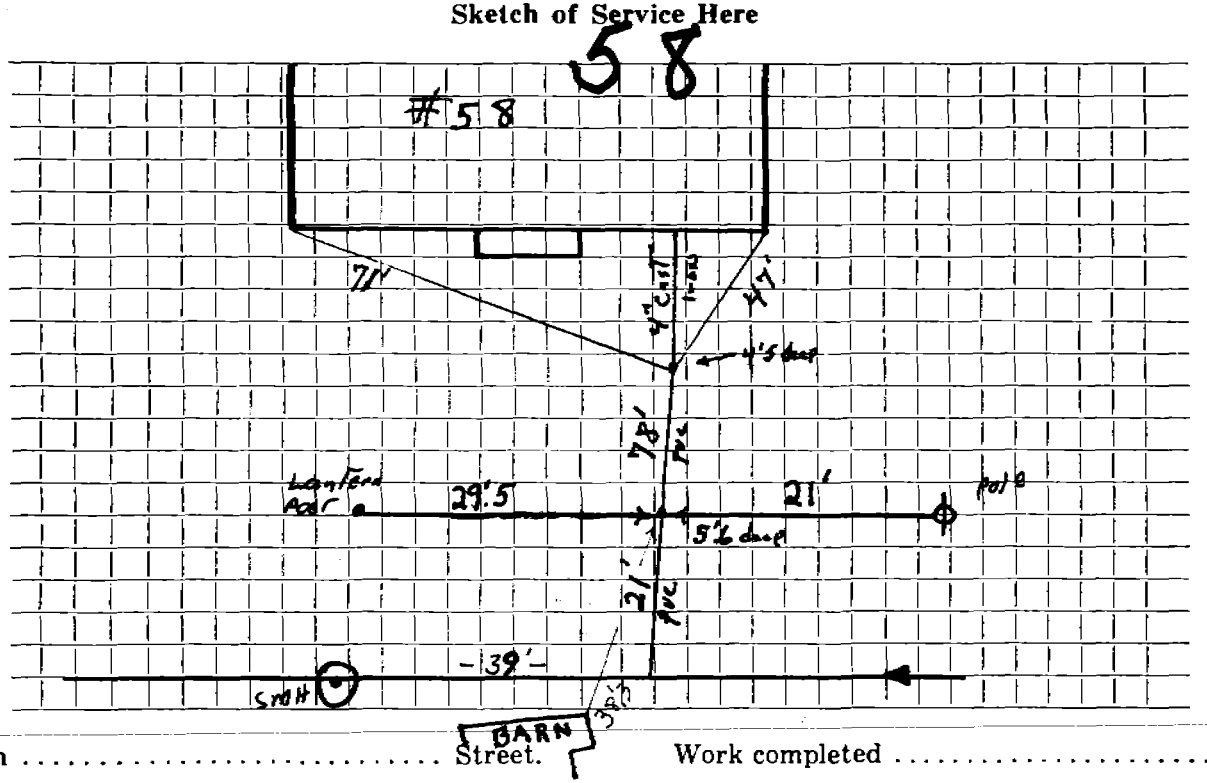

Connection made in ..... Street. Work completed .....

Remarks: .....

.....

....