Name Bernard Maloney **Service No.** 27

Address 33 Ames Avenue

Lot 494-495 Sta.4+76.3 **Location**

Kind of Pipe **Size** **Size of Main**

Repair—Renewal—New Service Valeri #1018 **Location** Aug 5 1968

Date		Material	Amount	Total	Date		Amount
8-21-63		Labor	94.64		5-7-68	Deposit	148.34
		10% O.H.	9.46	104.10			
	15'	6" Transite pipe @.82		12.30			
	1	$22\frac{1}{2}^{\circ}$ Transite Bend		4.09			
	1	$11\frac{1}{4}^{\circ}$ Transite Elbow		2.35			
	3	hrs. Town Shovel @6.50		19.50			
	2	hr. Trucking @3.00		6.00			
				148.34			

H.B.M.18501

DATE_____

TOWN OF LEXINGTON — BOARD OF PUBLIC WORKS

SEWER DIVISION

Sketch of Service Here 33

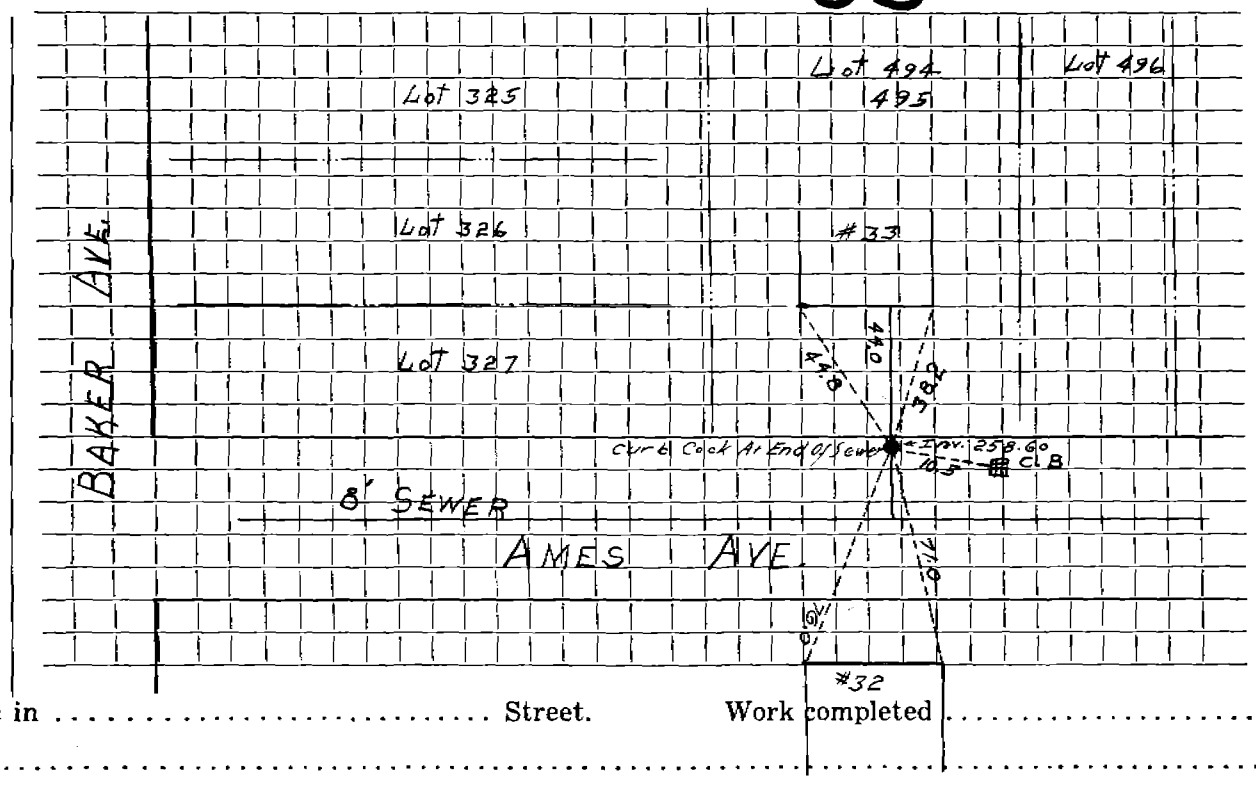

Connection made in ..... Street. Work completed .....

Remarks: .....

.....

.....