Name Frank J. Gallagher **Service No.** 6

Address 14 Appletree Lane

Location

Kind of Pipe **Size** **Size of Main**

Repair—Renewal—New Service Lexington Sewerage #1544 **Location** JUL 27 1970

Date		Material	Amount		Total		Date			Amount	
10/-/63		17.5' 6" A.C.					4-9-70		Deposit	105	00
		installed by									
		contractor @6.00									
		per foot	105	00							
		BILL WHEN CONNECTED									
4-9-70	85'	6" Transite Pipe									
	26'	4" Cast Iron Pipe									
	14'	3" Cast Iron pipe									

H.B.M.18501

DATE _____

TOWN OF LEXINGTON — BOARD OF PUBLIC WORKS

SEWER DIVISION

Sketch of Service Here

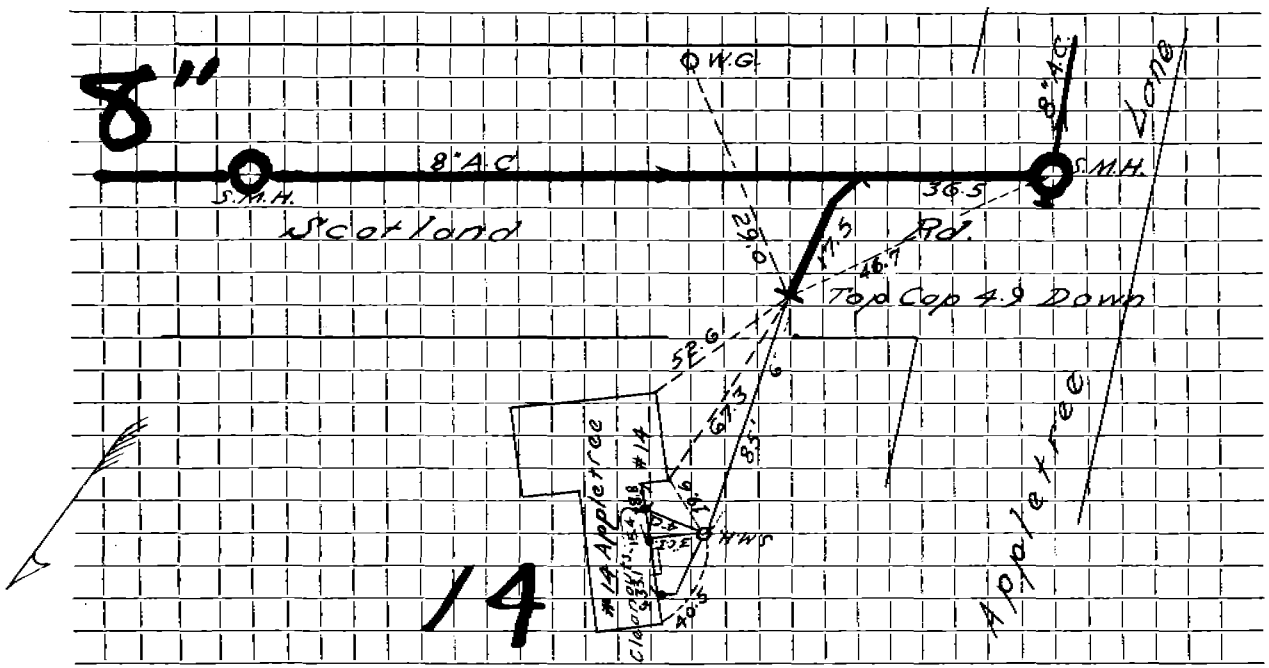

Connection made in ..... Street. Work completed .....

Remarks: .....

.....

.....