Name **Service No.**

Address 21 APPLETREE LA

Location

Kind of Pipe PVC **Size** 6" **Size of Main**

Repair—Renewal—New Service Teardown J McLaughlin **Location**

Date		Material	Amount	Total	Date		Amount
12/9/04	7.0	4" PVC Sch 40			5-16-73	20' - 6" TRANS	
	33.6	6" PVC				6" SADDLE	
	1	4X6 FERNCO					
	1	6" A.C. X PVC FERNCO					
		EXIT					
		A.C. PIPE					

DATE _____

TOWN OF LEXINGTON — BOARD OF PUBLIC WORKS

SEWER DIVISION

Sketch of Service Here

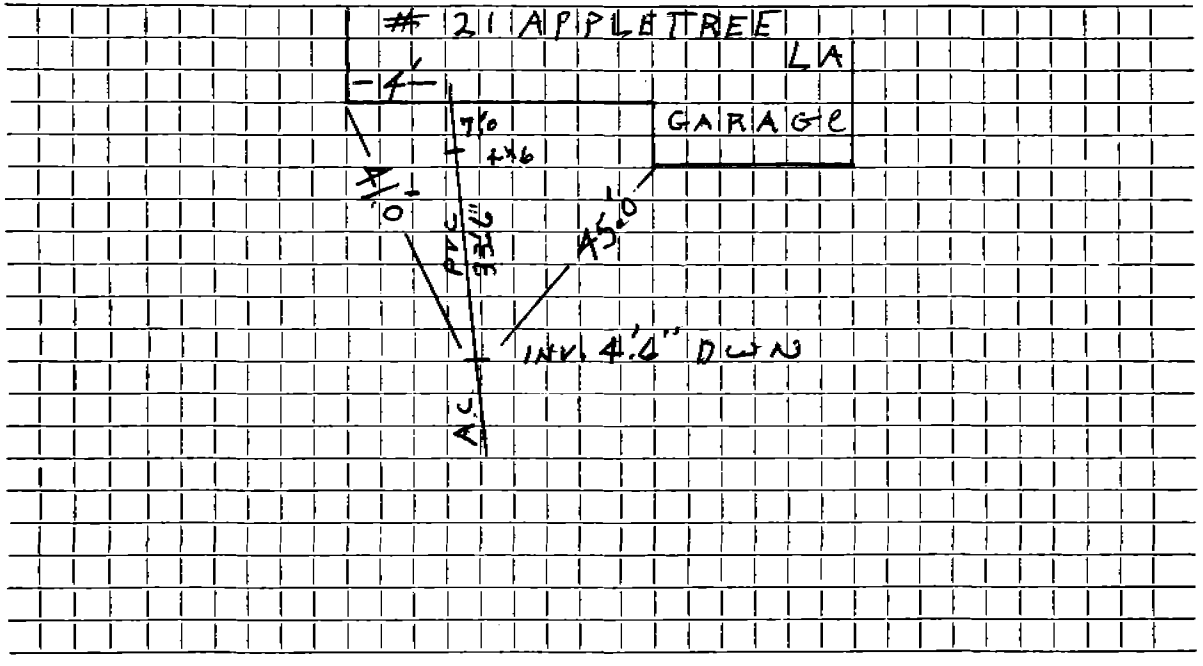

Connection made in ..... Street. Work completed 12/9/04 J. McLaughlin

Remarks: .....