Name Donald Irwin **Service No.** 172

Address 60 Baker Avenue

Lexington, Mass. **Location** 60 Baker Avenue

Kind of Pipe **Size** **Size of Main**

~~Repair Renewal~~ **New Service** Com. 8-16-48 **Location**

Date	Material	Amount	Total	Date		Amount
July 8, '48	Labor	27 99	27 99	July 7 '48	Excavated	65 00
	10% Overhead		2 80	Sept 9 '48	Card	8 37
	44' - 6" Sewer Pipe @.26		11 44	Nov. 8 '48	Card	1 00
	Joint Compound		2 64			74 37
	Littlefield Shovel 4 hrs. @	7.00	28 00			
	Trucking 2 hrs. @.75		1 50			
			74 37			
	Labor			6-6-87	Roots	

HP-7919

TOWN OF LEXINGTON—DEPT. OF PUBLIC WORKS

SEWER DIVISION

DATE ..... NO. .....

The undersigned applies for the construction of a particular sewer connecting No. ..... Street and hereby agrees to comply with the Rules and Regulations governing the construction and use of Particular Sewers, as now or at any future time established by the Board of Selectmen.

Am't of estimate $.....

Am't Paid $.....

..... Owner

Sketch of Service Here

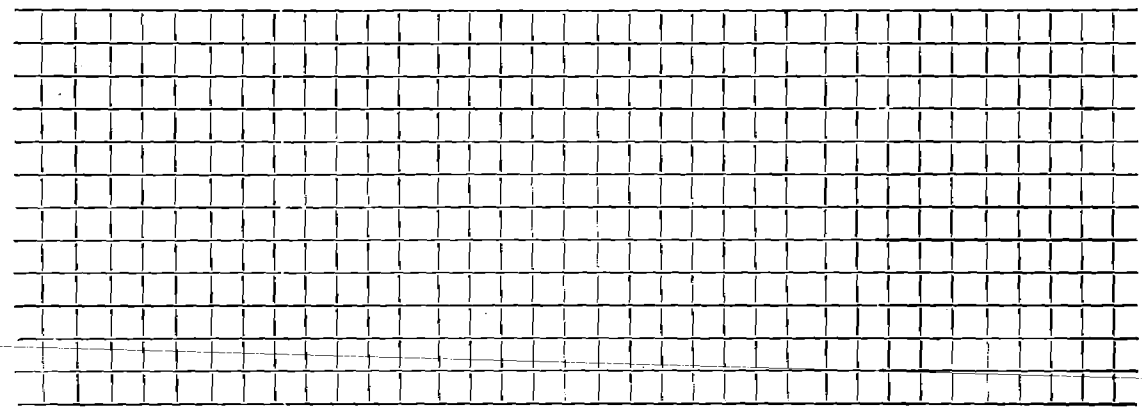

Connection made in ..... Street. Work completed ..... 19..

Remarks: