Name Rose A. Maloney **Service No.** 83

Address 77 Baker Avenue

Lexington, Mass. **Location** 77 Baker Avenue

Kind of Pipe **Size** **Size of Main**

~~XRepairXXXXXXXXX~~ **New Service** Com. 12-19-49 **Location**

Date	Material	Amount	Total	Date		Amount
Nov. 15, '49	Labor	14 40		Nov. 14 '49	Deposited	80 00
Nov. 16, '49	Labor	27 30	41 70	Dec. 31 '49	Refunded	6 71
	10% Overhead		4 17			73 29
	32' - 6" Sewer Pipe @.265		8 48			
	1 - 6" 1/8 Bend		1 52			
	Joint Compound		1 92			
	Littlefield Shovel 2 hrs. @7.00		14 00			
	Trucking 2 hrs. @.75		1 50			
			73 29			
				2-9-68	Solids	
				10-13-68	Solids	
	Labor					

HP-7919

TOWN OF LEXINGTON—DEPT. OF PUBLIC WORKS

SEWER DIVISION

DATE ..... NO. .....

The undersigned applies for the construction of a particular sewer connecting No. ..... Street and hereby agrees to comply with the Rules and Regulations governing the construction and use of Particular Sewers, as now or at any future time established by the Board of Selectmen.

Am't of estimate $. . . . . .

Am't Paid $. . . . . .

..... Owner

Sketch of Service Here

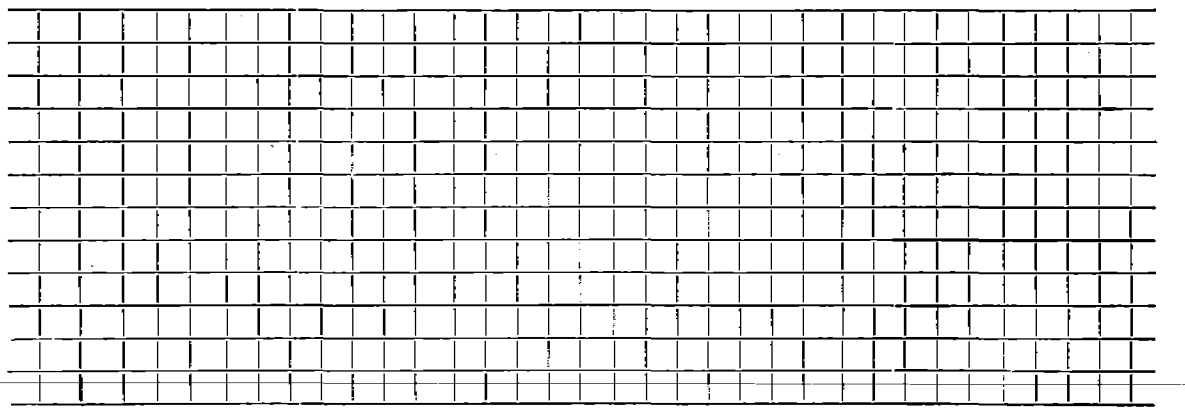

Connection made in ..... Street. Work completed ..... 19..

Remarks: