Name **Service No.**

Address # 45 BALFOUR

Location

Kind of Pipe PVC **Size** 4" & 6" **Size of Main**

Repair—Renewal—New Service **Location**

Date	Material	Amount	Total	Date		Amount
8/3/89	15 LF 4" PVC					
	112 LF 6" PVC					
	6"x4" WYE CLEANOUT					
	6x4" WYE					
	2 - 4"x6" FERNCO'S					
	6" - 22° ELBOW					

DATE _____

TOWN OF LEXINGTON — BOARD OF PUBLIC WORKS

SEWER DIVISION

Sketch of Service Here 45

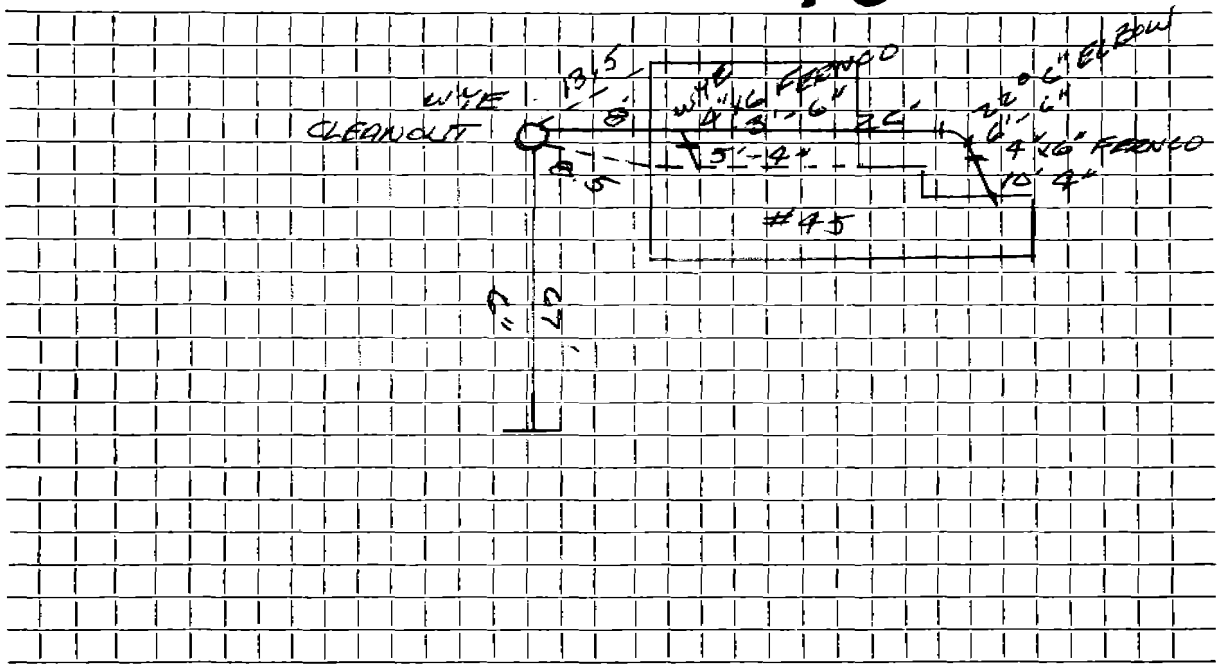

Connection made in BALFOUR Street. Work completed 8/3/89

Remarks: