Name

Service No. 3998

Address 3 Ballard Ter

Location

Kind of Pipe PVC + Clay Size 6" Size of Main

Repair—Renewal—New Service Location Lo T214 Pg. 71

Date		Material	Amount	Total	Date		Amount
4/8/11	2'	4" Sch 40					
	1	4" Clean out					
	4'	4" Sch 40					
	1	4X6 Fernco					
	35'	6" - PVC					
	1	6" - PVC x Clay	Fernco 5.6"	Down			
		Existing ST.					
1953		6" Clay Pipe					

DATE _____

TOWN OF LEXINGTON — BOARD OF PUBLIC WORKS

SEWER DIVISION

Sketch of Service Here

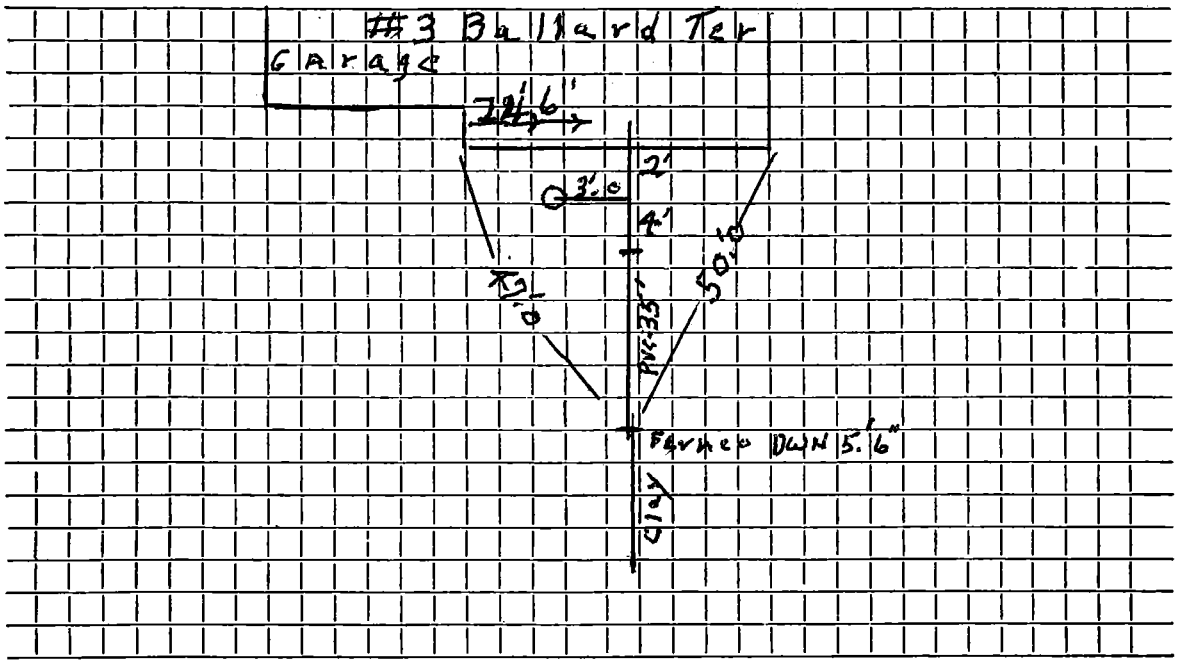

Connection made in ..... Street. Work completed 4-8-11

Remarks: Sewer Under Front Stairs. Clean out offset 3'

.....

.....