Name

Service No.

Address 29 Barberry Rd.

Location Lot L.C. 42

Kind of Pipe

Size

Size of Main

Repair—Renewal—New Service

Location

Date		Material	Amount		Total		Date			Amount	
1971											

H.R.R.18501

DATE _____

TOWN OF LEXINGTON — BOARD OF PUBLIC WORKS

SEWER DIVISION

Sketch of Service Here 29

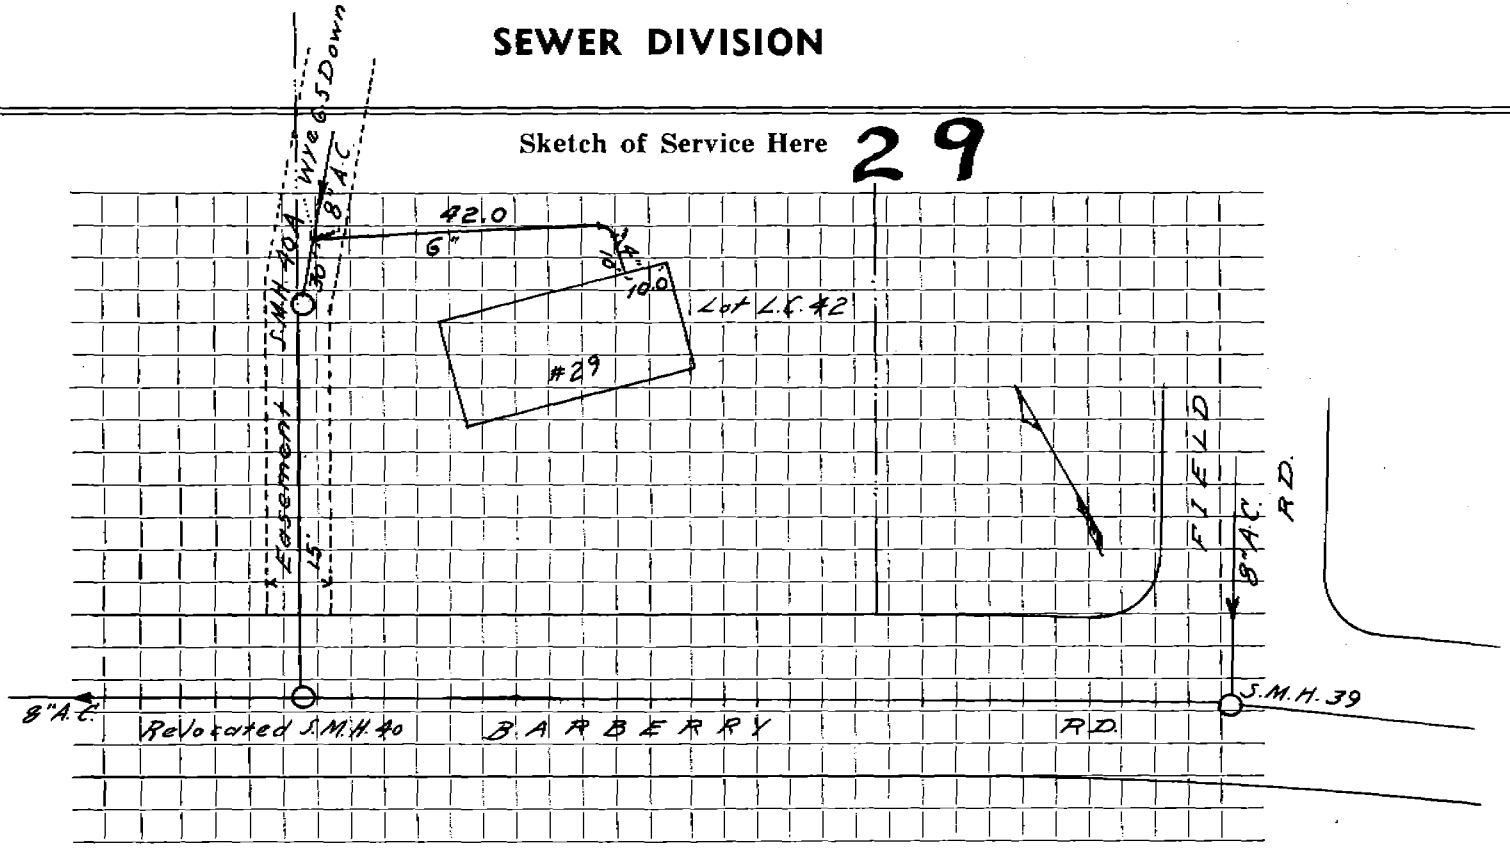

Connection made in ..... Street. Work completed .....

Remarks: .....

.....

.....