Name Donald R. Mapel **Service No.**

Address 31 Barberry Road

Location Lot L.C. 41

Kind of Pipe **Size** **Size of Main**

Repair—Renewal—New Service Lexington Sewerage #1942 **Location**

Date		Material	Amount		Total		Date			Amount	
11-20-71	73'	6" Transite pipe									
	20'	4" Cast Iron pipe									

L.B.W.185C1

DATE _____

TOWN OF LEXINGTON — BOARD OF PUBLIC WORKS

SEWER DIVISION

31

Sketch of Service Here

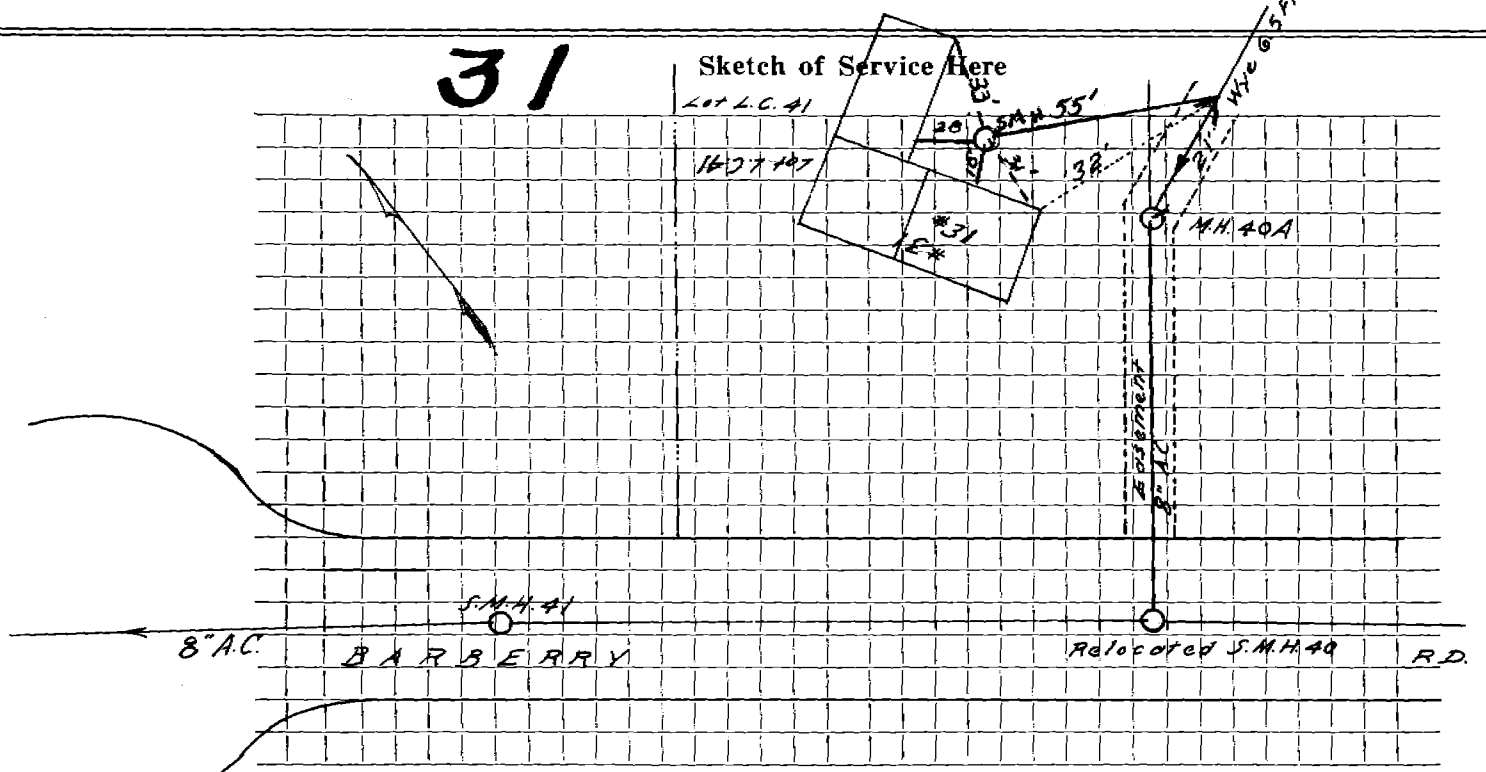

Connection made in ..... Street. Work completed .....

Remarks: .....

.....

.....