Name ALICE SWEENEY **Service No.** 75

Address #10 BARNES PL.

Location

Kind of Pipe A.C. **Size** 6" **Size of Main**

Repair—Renewal—New Service Valeri #3091 **Location** NOV. 13 1978

Date		Material	Amount		Total		Date			Amount	
8/23/78		7'. 6" ACP @	$16.	53	$115.	71	10-20-78		Deposit	115.	71
10/25/78	30'	6" Transite Pipe									
	5'	4" Cast Iron Pipe									

DATE _____

TOWN OF LEXINGTON — BOARD OF PUBLIC WORKS

SEWER DIVISION

Sketch of Service Here 10

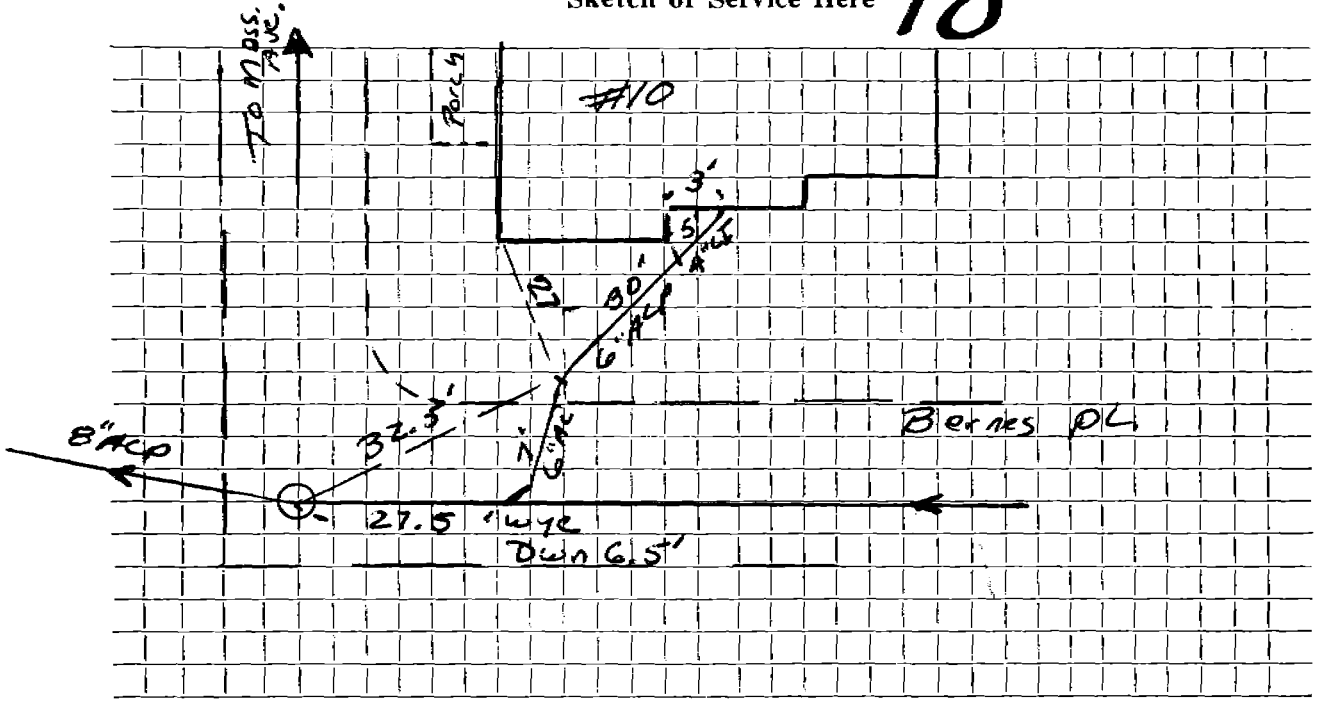

Connection made in Barnes Pl. ~~Street~~. Work completed .....

Remarks: .....